

SURVEY & REMONUMENTATION

JUL 16 1997

COMMISSION

LAND CORNER RECORDATION CERTIFICATE
Filing Requirement of Act 74, Mich. P.A. 1970

FILED

For corners in

<u>LIVINGSTON</u> (County)	Located In:	Corner Code #
1. Public Land Survey	T4N R 3E	M-9
	T___ R___	_____
	T___ R___	_____
	T___ R___	_____
2. Property Controlling in Section	S___ T___ R___	_____
	S___ T___ R___	_____
3. Miscellaneous Property in Sec.	S___ T___ R___	_____
	S___ T___ R___	_____

1997 MAY 27 P 3:40

NANCY HAVILAND
REGISTER OF DEEDS
LIVINGSTON COUNTY, MI.
48843

L.S.C.# 666m

Register of Deeds Stamp & File Number

4. Lot No. _____, Recorded Plat _____
5. Private Claims _____

I, CHARLES E GARLOCK, in a field survey on MAY 20, 1997 do hereby state that under requirements of P.A. 74, Michigan P.A. of 1970, the corner points mentioned in lines 1 and 2 above were in conformance with regulations and rules therefore as required in the current manual of survey instructions of the United States Department of the Interior, Bureau of Land Management or by a decree of a Court of Law and/or that the corner points mentioned in lines 3, 4 and 5 above were in conformance with the rules of the Michigan Board of Land Surveyors or by a Decree of a Court of Law; established, re-established, monumented, recovered, found as expressed below:

NOTE: Not more than 2 corners, all in the same town and range, may be recorded on this certificate.

A	B	C	D	E	F	G	H	I	J	K	L	M
1												
2	6	5	4	3	2	1						
3												
4	7	8	9	10	11	12						
5												
6	10	17	16	15	14	13						
7												
8	19	20	21	22	23	24						
9												
10	30	29	28	27	26	25						
11												
12	31	32	33	34	35	36						
13												

A. Description of original monument and accessories and/or subsequent restoration:
GLO SURVEY DATED APRIL 15, 1825 BY S SIBLEY AND NONE OF THE GLO WITNESSES REMAIN
GLO WITNESSES: W030-N76E-75 LKS
W0 8-S13 1/2E-107 LKS


ADDITIONAL DATA ON REAR OF SHEET

B. Description of corner evidence found and/or method applied in restoring or reestablishing corner:
FD. BUGGLE AXLE AND BRICK AT -1.8' AS PER 1900+/- WITNESSES BY McCREARY

C. Description of monument for corner and accessories established to perpetuate locating the position of the corner:
M-9: SE COR. SEC. 24 T4N-R3E CONWAY TWP. LIV. CO. MI. RAISED BUGGLE AXLE W/1 1/4" X 6" I. PIPE CEMENTED TO TOP WITH LIV. CO. REMON BRASS CAP ON TOP OF I. PIPE AT -0.7'
S58W-42.70'-FACE 4" STEEL POST
N52W-67.80'-SP 7 TAG W/S U POLE
N42W-43.50'-AT BASE ON SE COR. CONCRETE PILLAR
N33E-81.58'-SP & TAG W/S 36" WALNUT (1900 WIT.)
WEST-1'-N-S ROAD
NORTH-3'-ROAD TO WEST
SOUTH-9.79'-SEC. COR. FOR T4N-R4E OVER.

Signed by Charles E. Garlock
Surveyor's Michigan License No. 14762

Date MAY 20, 1997

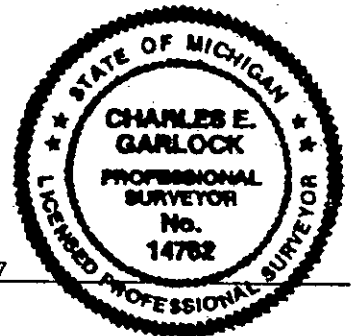

PA. 345 1990, APPROVED BY LIVINGSTON COUNTY
PEER GROUP ON 2/5/1997 CO. REP JEO

"Be Sure of Your Ground"

CHARLES E. GARLOCK

PROFESSIONAL SURVEYOR
705 N. MICHIGAN AVE.
HOWELL, MICHIGAN 48843
OFFICE: (517) 546-3340
FAX: 517 546-2941

DECEMBER 30, 1996



CORNER SUMMARY


M-9: SE CORNER SECTION 24, T4N-R3E, CONWAY TWP. LIV. CO. MI.

GLO SURVEY DATED APRIL 15, 1825 BY S SIBLEY, DS, AND NONE OF THE GLO WITNESSES REMAIN.

TRIPLE CORNER

AROUND 1900± MC CREARY SET A BUGGY AXLE WITH BRICK AROUND IT, ONE WITNESS REMAINS AND IT CHECKS, THE SECOND WITNESS GOES TO A NOW ROTTED STUMP AND IT ALSO CHECKS±. IN 1970 CONSUMERS POWER FOUND A FLAT IRON BAR AND SET A "T" IRON BESIDE IT. WE FOUND THAT THE SO CALLED IRON BAR IS A LAWN MOWER BLADE ON END, SET BY WHO IS A MYSTERY. WE ALSO FOUND A 1/2" I. ROD (SOMETIMES CALLED A 5/8" I. ROD) THAT WAS USED BY NEWTON-'73, BOYD-?, ALBRIGHT-'72, THOMPSON-'92, GARLOCK-'73, BOSS-'86, HUGHES-'89, DESINE-'93, BOSS-'93, BOSS-'74, AND NEWTON AGAIN WITH LCRC. ALL OF THEIR REMAINING WITNESSES CHECK TO THE 1/2" I. ROD. WE ALSO FOUND A 5/8" I. ROD SOUTH 13.21 FEET FROM THE ABOVE 1/2" I. ROD, THIS 5/8" I. ROD IS USED FOR A COHOCTAH TWP. CORNER. SOUTH OF THE BUGGY AXLE WE ALSO FOUND AN ANCHOR BOLT WITH AN EYE LOOP ON TOP AT 9.79 FEET SOUTH, GLO CALLS FOR A JOG OF 9.24 FEET. THE FOUND IRONS IN RELATION TO THE FOUND BUGGY AXLE ARE AS FOLLOWS: SOUTH 0.53' AND EAST 1.98 FEET TO THE 1/2" I. ROD (EVERYONE USED THIS FOR M-9); SOUTH 4.46 FEET AND EAST 1.76 FEET TO THE I. BAR (MOWER BLADE) AND "T" IRON; SOUTH 9.79 FEET AND WEST 0.36 FEET TO THE ANCHOR BOLT W/LOOP AND SOUTH 13.74 FEET X 1.82 FEET EAST TO THE 5/8" I. ROD. ANCHOR BOLT AND 5/8" I. ROD ARE INTENDED TO BE THE COHOCTAH TWP. CORNER. SITE IS GOOD FOR GPS. HUGHES HAD FOUND THE BUGGY AXLE PREVIOUSLY, BUT DID NOT KNOW IT FOR AN AXLE AND USED THE 1/2" I. ROD EVERYONE ELSE HAS USED FOR M-9. I HAVE KNOWN FROM PAST EXPERIENCE THAT MC CREARY DROVE THE ENTIRE AXLE 6-7 FEET IN LENGTH IN THE GROUND AND WAS QUITE DILIGENT ABOUT HIS WORK. WE MEASURED FROM THE BUGGY AXLE NORTH 2662.29 AND SOUTH 2651.88. OTHERS MEASURED FROM THE 1/2" I. ROD NORTH 2661.29-CANTOR AND THOMPSON 2662.62 & SOUTH 2651.25-BOSS, 2662.54-CHMP, 2651.47-BOSS, 2651.44-DESINE AND 2650.98-GARLOCK. I RECOMMEND THE BUGGY AXLE TO NOW BE USED AS THE PROPER SE CORNER OF SECTION 24. IT IS UNFORTUNATE THAT ONE OF US FINDS A CORNER, USES IT AND THE REST OF US SO MANY TIMES SWEAR TO IT WITHOUT CONTINUING OUR RESEARCH AS WE SHOULD.

Handwritten signature of Charles E. Garlock
CHARLES E GARLOCK, PS
CON97M9

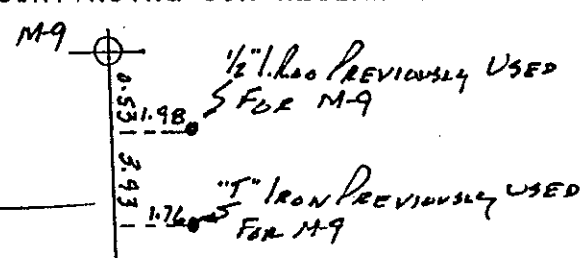

SUCCESSOR TO:

- MILES W. BULLOCK, L.S. (1844 TO 1926)
CLAY W. GORDON, RLS (1883 TO 1970)
GRANT H DUNNING, P.E. (1865 TO 1925)
LYLE W. MUNSELL, RLS (1904 TO 1987)