

JUL 16 1997

COMMISSION

LAND CORNER RECORDATION CERTIFICATE
Filing Requirement of Act 74, Mich. P.A. 1970

FILED

For corners in

<u>LIVINGSTON</u> (County)	Located In:	Corner Code #
1. Public Land Survey	T <u>4N</u> R <u>3E</u>	<u>M-10</u>
	T <u> </u> R <u> </u>	<u> </u>
	T <u> </u> R <u> </u>	<u> </u>
	T <u> </u> R <u> </u>	<u> </u>
2. Property Controlling in Section	S <u> </u> T <u> </u> R <u> </u>	<u> </u>
	S <u> </u> T <u> </u> R <u> </u>	<u> </u>
3. Miscellaneous Property in Sec.	S <u> </u> T <u> </u> R <u> </u>	<u> </u>
	S <u> </u> T <u> </u> R <u> </u>	<u> </u>

1997 MAY 27 P 3:40

NANCY HAVILAND
REGISTER OF DEEDS
LIVINGSTON COUNTY, MI.
48843

L.S.C.#667m

Register of Deeds Stamp & File Number

4. Lot No. _____, Recorded Plat _____
5. Private Claims _____

I, CHARLES E GARLOCK, in a field survey on MAY 20, 19 97 do hereby state that under requirements of P.A. 74, Michigan P.A. of 1970, the corner points mentioned in lines 1 and 2 above were in conformance with regulations and rules therefore as required in the current manual of survey instructions of the United States Department of the Interior, Bureau of Land Management or by a decree of a Court of Law and/or that the corner points mentioned in lines 3, 4 and 5 above were in conformance with the rules of the Michigan Board of Land Surveyors or by a Decree of a Court of Law; established, re-established, monumented, recovered, found as expressed below:

NOTE: Not more than 2 corners, all in the same town and range, may be recorded on this certificate.

1	A	B	C	D	E	F	G	H	I	J	K	L	M
2		6		5		4		3		2		1	
3													
4		7		8		9		10		11		12	
5													
6		18		17		16		15		14		13	
7													
8		19		20		21		22		23		24	
9													
10		30		29		28		27		26		25	
11													
12		31		32		33		34		35		36	
13													

A. Description of original monument and accessories and/or subsequent restoration:
GLO SURVEY DATED APRIL 15, 1825 BY S SIBLEY AND NONE OF THE GLO WITNESSES REMAIN
GLO WITNESSES: WO 12-N19W-88 LKS
BO 24-140 LKS-S40E


ADDITIONAL DATA ON REAR OF SHEET

B. Description of corner evidence found and/or method applied in restoring or reestablishing corner:
FD. "T" SET BY CONS. POWER AS PER C W GORDON 1938 WITNESSES.

C. Description of monument for corner and accessories established to perpetuate locating the position of the corner:
M-10: E 1/4 COR. SEC. 25 T4N-R3E, CONWAY TWP. LIV. CO. MI, REPLACED ABOVE WITH 1 1/4" X 36" I. PIPE (BREAKAWAY) WITH LIV. CO. REMON BRASS CAP ON TOP AT -0.5'
N10W-98.21'-SP & TAG E/S 48" OAK
WEST-32.95'-FACE OF 2" ANGLE IRON POST
S87W-47.10'-SP & TAG N/S 9" SPRUCE
S54E-36.63'-SP & TAG S/S 12" MAPLE
S25E-54.69'-SP & TAG W/S 18" OAK
ON C/L ROAD TO N & S AND LINES W/ FENCE TO WEST
SOUTH-14.54'-1/4 COR. FOR T4N-R4E

Signed by Charles E Garlock
Surveyor's Michigan License No. 14762

Date MAY 20, 1997

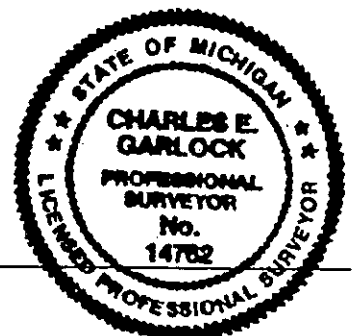

CHARLES E. GARLOCK

PROFESSIONAL SURVEYOR

705 N. MICHIGAN AVE.

HOWELL, MICHIGAN 48843

OFFICE: (517) 546-3340

FAX: 517 546-2941

DECEMBER 30, 1996

CORNER SUMMARY

M-10: E 1/4 COR. SECTION 25, T4N-R3E, CONWAY TWP. LIV, CO., MI.

GLO SURVEY DATED APRIL 15, 1825 BY S SIBLEY, DS, AND NONE OF THE GLO WITNESSES REMAIN.

CLAY GORDON IN 1938 SHOWS THE EAST 1/4 CORNER IN LINE WITH THE NORTH LINE OF A CEMETERY FENCE AND IS LOCATED 33 FEET FROM THE CEMETERY FENCE POST. NEWTON-'73, CONSUMERS POWER-'70, DESINE-'93 AND BOSS-'93 FOUND M-10 33 FEET± EAST OF THE CEMETERY CORNER FENCE POST. WITNESSES TO A FOUND "T" IRON BY NEWTON, CONSUMERS POWER, DESINE, BOSS AND CHMP ALL CHECK. WE FOUND THE "T" IRON AND ALSO THE COHOCTAH CORNER SOUTH AT 14.54 FEET, GLO CALCS THE JOG TO BE 12.87 FEET. MEASURED NORTH 2651.88 TO THE BUGGY AXLE AND SOUTH 2650.90 TO A REMON. CORNER, DESINE HAD 2650.91 TO THE SOUTH AND BALANCE OF SURVEYORS MEASURED NORTH TO THE 1/2" I. ROD THE FOLLOWING: BOSS-2651.25, CHMP-2662.54, BOSS-2651.47, DESINE-2651.44 AND GARLOCK-2650.98.

LOCATION IS GOOD FOR GPS.

I RECOMMEND WE USE THE CORNER AS FOUND.

CHARLES E GARLOCK, PS

CON97M10

SUCCESSOR TO:

MILES W. BULLOCK, L.S. (1844 TO 1926)

GRANT H DUNNING, P.E. (1865 TO 1928)

CLAY W. GORDON, RLS (1883 TO 1970)

LYLE W. MUNSELL, RLS (1904 TO 1987)

433E
M10
4