

**SURVEY &
REMONUMENTATION**

FEB 26 2001

SECTION

**LAND CORNER RECORDATION CERTIFICATE
Filing Requirement of Act 74, Mich. P.A. 1970**

FILED

For corners in

<u>LIVINGSTON</u> (County)	Located In:	Corner Code #
1. Public Land Survey	<u>T 4 N R 3 E</u>	<u>I-05</u>
	T <u> </u> R <u> </u>	<u> </u>
	T <u> </u> R <u> </u>	<u> </u>
	T <u> </u> R <u> </u>	<u> </u>
2. Property Controlling in Section	S <u> </u> T <u> </u> R <u> </u>	<u> </u>
	S <u> </u> T <u> </u> R <u> </u>	<u> </u>
3. Miscellaneous Property in Sec.	S <u> </u> T <u> </u> R <u> </u>	<u> </u>
	S <u> </u> T <u> </u> R <u> </u>	<u> </u>

2000 SEP 28 10 18

NANCY HAVILAND
REGISTER OF DEEDS
LIVINGSTON COUNTY, MI.
48843

LSC #1282m

Register of Deeds Stamp & File Number

4. Lot No. _____, Recorded Plat _____
5. Private Claims _____

I, JACK K. SMITH, in a field survey on JULY 20, 2000 do hereby state that under requirements of P.A. 74, Michigan P.A. of 1970, the corner points mentioned in lines 1 and 2 above were in conformance with regulations and rules therefore as required in the current manual of survey instructions of the United States Department of the Interior, Bureau of Land Management or by a decree of a Court of Law and/or that the corner points mentioned in lines 3, 4 and 5 above were in conformance with the rules of the Michigan Board of Land Surveyors or by a Decree of a Court of Law; established, re-established, monumented, recovered, found as expressed below:

NOTE: Not more than 2 corners, all in the same town and range, may be recorded on this certificate.

1	A	B	C	D	E	F	G	H	I	J	K	L	M
2		6		5		4		3		2		1	
3													
4		7		8		9		10		11		12	
5													
6		18		17		16		15		14		13	
7													
8		19		20		21		22		23		24	
9													
10		30		29		28		27		26		25	
11													
12		31		32		33		34		35		36	
13													

A. Description of original monument and accessories and/or subsequent restoration:

GLO, SURVEY DATED: APRIL 15, 1825 BY S. SIBLEY
GLO WITNESSES: ELM 11" N20 1/2°W 330.00'
ASPEN 10" N29°E 274.56'

B. Description of corner evidence found and/or method applied in restoring or reestablishing corner:

FOUND RAILROAD SPIKE OVER A 5/8" REROD

C. Description of monument for corner and accessories established to perpetuate locating the position of the corner:


I-05: NORTHWEST CORNER OF SECTION 14, T4N-R3E, CONWAY TOWNSHIP, LIVINGSTON COUNTY, MICHIGAN.
SET A 1 1/4" X 36" BREAKAWAY STEEL PIPE WITH LIVINGSTON COUNTY REMON BRASS CAP # 35999.

S75°E SP & LIV. COUNTY REMON. TAG ON THE TOP OF MOST S'LY GUARD RAIL POST 51.59'
N45°E SP & LIV. COUNTY REMON. TAG ON THE WEST SIDE OF A UTILITY POLE 163.74'
N25°W SP & LIV. COUNTY REMON. TAG ON THE EAST SIDE OF A 16" WALNUT 25.02'
N40°W SP & LIV. COUNTY REMON. TAG ON THE SOUTH SIDE OF A UTILITY POLE 126.16'
ON C/L OF FOWLerville ROAD TO THE SOUTH AND 6 FT.+/- NORTH OF C/L OF MOHRLE ROAD

Signed by [Signature]

Date JULY 20, 2000

Surveyor's Michigan License No. 35999

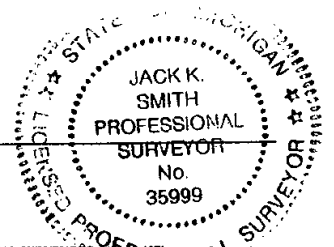

FORM APPROVED BY MICHIGAN STATE BOARD OF PROFESSIONAL SURVEYORS, JAN 1982
REVISED MAY 14, 1975 REVISED JAN, 1983 REVISED OCT, 1995

PA. 345 1980, APPROVED BY LIVINGSTON COUNTY

PEER GROUP ON 2-16-2000 CO. REP ✓ED