

MAR 17 2000

FILED

SECTION

LAND CORNER RECORDATION CERTIFICATE

Filing Requirement of Act 74, Mich. P.A. 1970

1999 SEP 10 A 9:04

For corners in

Livingston Located in: Corner Code #
 (County)

1. Public Land Survey T 4N R 4E D-9
 T R
 2. Property Controlling S T R
 in Section S T R
 3. Miscellaneous S T R
 Property in Sec. S T R

9-

NANCY HAVILAND
 REGISTER OF DEEDS
 LIVINGSTON COUNTY, MI.
 48843

LSC #1052m
 Register of Deeds Stamp & File Number

4. Lot No. _____, Recorded Plat _____
 5. Private Claims _____

I, John H. Rauser, P.S., in a field survey on June 1999, do hereby certify that under requirements of P.A. 74, Michigan P.A. of 1970, the corner points mentioned in lines 1 and 2 above were in conformance with regulations and rules therefore as required in the current manual of survey instructions of the United States Department of the Interior, Bureau of Land Management or by a decree of a Court of Law and/or that the corner points mentioned in lines 3, 4 and 5 above were in conformance with the rules of the Michigan Board of Land Surveyors or by a Decree of a Court of Law; established, re-established, monumented, re-monumented, recovered, found as expressed below:

1	A	B	C	D	E	F	G	H	I	J	K	L	M
2	6	5	4	3	2	1							
3													
4	7	8	9	10	11	12							
5													
6	18	17	16	15	14	13							
7													
8	19	20	21	22	23	24							
9		29	28	27	26	25							
10	30												
11													
12	31	32	33	34	35	36							
13													

NOTE: Not more than 2 corners, all in the same town and range, may be recorded on this certificate.

A. Description of original monument and accessories and/or subsequent restoration:

D-9 Common 1/4 Corner, Sections 20 & 29, T4N-R4E

1823 Wood post placed by Sylvester Sibley, D.S.
 S41 1/2 E 57lks (37.62') 20" W. Oak
 N17 1/2 W 22lks (14.52') 14" W. Oak

(Additional information on back)

B. Description of corner evidence found and/or method applied in restoring or reestablishing corner:


D-9 Common 1/4 Corner, Sections 20 & 29, T4N-R4E

Found a 1/2" re-rod with smashed cap in fence line to the East and West. Found fence post with newer fence North, 5' West of iron.

C. Description of monument for corner and accessories established to perpetuate locating the position of the corner:

D-9 Common 1/4 Corner, Sections 20 & 29, T4N-R4E

Standard Livingston County Remon iron pipe with brass cap
 S60W 31.99' Fnd nail w/Boss flag SE-side 12" Oak
 N30E 33.72' Fnd nail in 8" Hickory ENE fc
 N10E 23.66' Fnd nail WNW fc 20" Oak
 N80E 37.61' Fnd PK NNE fc 36" Oak
 N80E 9.46' Fnd nail N fc Crab Apple
 East 5.11' Fnd nail N fc fence post
 West 3.85' Fnd nail w/flag S fc 8" Oak

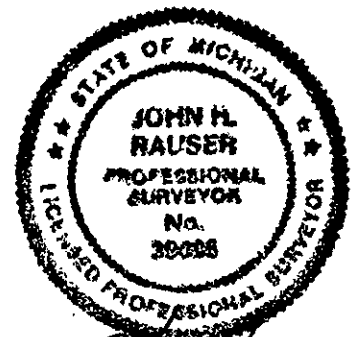

Signed by John H. Rauser

Date 8/18/99

Surveyor's Michigan License No. 39096

PA. 345 1999, APPROVED BY LIVINGSTON COUNTY
 PEER GROUP ON 5-19-99, CO. REP. JED