

MAR 17 2000

FILED

LAND CORNER RECORDATION CERTIFICATE

Filing Requirement of Act 74, Mich. P.A. 1970

1999 SEP 10 A 9:04

SECTION

For corners in

9-

NANCY HAVILAND REGISTER OF DEEDS LIVINGSTON COUNTY, MI. 48843

Livingston (County) Located In: Corner Code #

- 1. Public Land Survey T 4N R 4E E-9
2. Property Controlling in Section S T R
3. Miscellaneous Property in Sec. S T R

LSC #1053m Register of Deeds Stamp & File Number

- 4. Lot No. Recorded Plat
5. Private Claims

I, John H. Rauser, P.S., in a field survey on June 1999 do hereby certify that under requirements of P.A. 74, Michigan P.A. of 1970, the corner points mentioned in lines 1 and 2 above were in conformance with regulations and rules therefore as required in the current manual of survey instructions of the United States Department of the Interior, Bureau of Land Management or by a decree of a Court of Law and/or that the corner points mentioned in lines 3, 4 and 5 above were in conformance with the rules of the Michigan Board of Land Surveyors or by a Decree of a Court of Law; established, re-established, monumented, re-monumented, recovered, found as expressed below:

Table with 13 rows and 13 columns (A-M) containing numbers 1-36 in a grid pattern.

NOTE: Not more than 2 corners, all in the same town and range, may be recorded on this certificate.

A. Description of original monument and accessories and/or subsequent restoration:

E-9 Common Corner, Sections 20, 21, 28, & 29, T4N-R4E

1823 Wood post placed by Sylvester Sibley, D.S. N12E 50lks (33") 10" Spruce S52E 49lks (32.34') 10" Spruce

(Additional information on back)

B. Description of corner evidence found and/or method applied in restoring or reestablishing corner:

E-9 Common Corner, Sections 20, 21, 28 & 29, T4N-R4E


Found a 5" steel post in concrete.

C. Description of monument for corner and accessories established to perpetuate locating the position of the corner:

E-9 Common Corner, Sections 20, 21, 28, & 29, T4N-R4E

Left 5" steel post in concrete in place, with new chiseled "+" on the SE side at the corner position.

- N40E 15' Set 1 1/4" X 36" reference pipe with brass cap
S45E 15' Set 1 1/4" X 36" reference pipe with brass cap
S55E 15' Set 1 1/4" X 36" reference pipe with brass cap
N60W 15' Set 1 1/4" X 36" reference pipe with brass cap

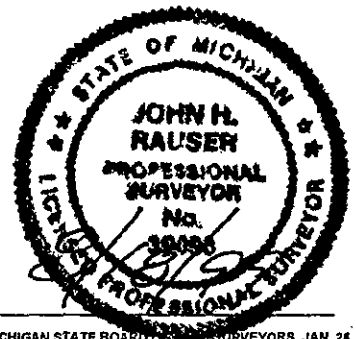

Signed by [Signature] Surveyor's Michigan License No. 39096

Date