

FILED

JUL 14 9 46 AM '95

LAND CORNER RECORDATION CERTIFICATE  
Filing Requirement of Act 74, Mich. P.A. 1970

NANCY HAYLANE  
REGISTER OF DEEDS  
LIVINGSTON COUNTY, MI  
48843

For corners in Livingston (County) Located In: Corner Code #

1. Public Land Survey T 4N R 4E E-12  
 T \_\_\_\_\_ R \_\_\_\_\_  
 T \_\_\_\_\_ R \_\_\_\_\_  
 T \_\_\_\_\_ R \_\_\_\_\_

2. Property Controlling in Section S \_\_\_\_\_ T \_\_\_\_\_ R \_\_\_\_\_  
 S \_\_\_\_\_ T \_\_\_\_\_ R \_\_\_\_\_

3. Miscellaneous Property in Section S \_\_\_\_\_ T \_\_\_\_\_ R \_\_\_\_\_  
 S \_\_\_\_\_ T \_\_\_\_\_ R \_\_\_\_\_

L.S.C. #415 m

Register of Deeds Stamp & File Number

4. Lot No. \_\_\_\_\_, Recorded Plat \_\_\_\_\_  
 5. Private Claims \_\_\_\_\_

	A	B	C	D	E	F	G	H	I	J	K	L	M
2	6		5		4		3		2		1		
3													
4	7		8		9		10		11		12		
5													
6	18		17		16		15		14		13		
7													
8	19		20		21		22		23		24		
9													
10	30		29		28		27		26		25		
11													
12	31		32		33		34		35		36		
13													

I, Edward E. Anderson, in a field survey on June 27, 1995, do hereby certify that under requirements of P.A. 74, Michigan P.A. of 1970, the corner points mentioned in lines 1 and 2 above were in conformance with regulations and rules therefore as required in the current manual of survey instructions of the United States Department of the Interior, Bureau of Land Management or by a decree of a Court of Law and/or that the corner points mentioned in lines 3, 4 and 5 above were in conformance with the rules of the Michigan Board of Professional Surveyors or by a Decree of a Court of Law; established, re-established, monumented, re-monumented, recovered, found as expressed below:

NOTE: Not more than 4 corners, all in the same town and range, may be recorded on this certificate.

A. Description of original monument and accessories and/or subsequent restoration:

- G.L.O. Notes dated June 20, 1823
- G.L.O. Witnesses B. Oak 20" N55 1/2°E, 34 Lks
- W. Oak 14" N53 1/2°W, 55 Lks

Additional historical data on back

B. Description of corner evidence found and/or method applied in restoring or reestablishing corner:


Found 1/2" capped iron. Fit witnesses by Boss, C.H.M.P., Hughes, and Shellenberger

C. Description of monument for corner and accessories established to perpetuate locating the position of the corner:

E-12 E 1/4 COR. SEC. 32, T4N-R4E

- Set 36" x 1 1/4" Breakaway iron pipe with Brass Cap (Liv. Co. Mon. Cor.)
- in centerline Burkhardt Road.
- N23°E 59.58' Spike W/S 8" Locust
- S30°E 37.11' Spike N/S 18" Oak
- S30°W 42.38' Spike E/S 24" Walnut
- S65°W 22.62' Spike N/S 20" Walnut

Signed by [Signature]  
 Surveyor's Michigan License No. 11495

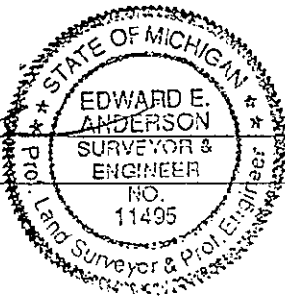

Date July 5, 1995

FORM APPROVED BY MICHIGAN STATE BOARD OF PROFESSIONAL SURVEYORS, JAN. 28, 1971  
REVISED MAY 14, 1975  
REVISED JAN., 1983

P.A. 343 1990, APPROVED BY LIVINGSTON COUNTY

PFER GROUP ON 4/5/95 ON FD



EDWARD E. ANDERSON, P.S., P.E.  
RICHARD F. FRANK, P.S.  
BRIAN R. SHALTZ, C.S.T.

Members of:  
Michigan Society of Professional Surveyors  
American Congress on Surveying and Mapping  
American Society of Civil Engineers

401 S. Leroy St.  
Fenton, Michigan 48430-2164

(313) 629-8974  
FAX (313) 629-9069

SUMMARY

March 23, 1995

E-12 EAST 1/4 CORNER SECTION 32, T4N-R4E, COHOCTAH TOWNSHIP,  
LIVINGSTON COUNTY, MICHIGAN

Found 1/2" capped rerod (#30101 Shellenbarger) in the centerline of Burkhart Road (gravel) running north and south.

Checked and measured to witnesses we found. Found all of Boss witnesses and they checked, page 8, this dossier. Found all of C.H.M.P. witnesses. They checked, pages 9 and 10 this dossier. Found 3 of 4 of Hughes witnesses and they checked, page 12 this dossier. Found all of Shellenbargers witnesses and they checked, pages 13 and 15 this dossier.

Distance from the East 1/4 corner to the S.E. corner of said Section 32 is 2659.42', C.H.M.P. survey, page 8 this dossier; and 2658.99', Hughes survey, page 11 this dossier, and 2659.83', Shellenbarger survey, page 14 this dossier.

Distance from the East 1/4 corner to the N.E. corner of said Section 32 is 2672.98', Hughes survey, page 11 this dossier, and 2673.25', Shellenbarger survey, page 14 this dossier.

Made a clean sweep of immediate area and found no other corners or irons.

Gravel roads running north and south, flat in both directions.

Terrain is open in all directions. Church to S.W. and barn to S.E. Fence and tree line running to the east and west.

Poor location for G.P.S.

Came to the conclusion that the 1/2" rerod we found was the correct East 1/4 corner of said Section 32.

*E. Anderson*  
Edward E. Anderson  
P.S.#11495  
SURVEYOR & ENGINEER  
NO. 11495  
STATE OF MICHIGAN  
Professional Surveyors & Professional Engineers