## LAND CORNER RECORDATION CERTIFICATE

JUL 14 9 45 AH '95

For corners in Livingston (County)	Located In:	Corner Code #	NANCY HAVILAND REGISTER OF DEEDS LIVINGSTON COUNTY, HT 48843
Public Land Survey	T <u>4 N</u> R <u>4 E</u> T R T R		
<ol> <li>Property Controlling in Section</li> <li>Miscellaneous Property in Section</li> </ol>	S T R S T R S T R S T R		L.S.C.#408m Register of Deeds Stamp & File Number
5. Private Claims  L. Edward E. Anders do hereby certify that under r in lines 1 and 2 above were in manual of survey instructio Management or by a decree 5 above were in conformance Decree of a Court of Law; es as expressed below: NOTE: Not more than 4 con this certificate.  A. Description of original	al monument and accessories a	y 5,	urrent Land 4 and 5 19 20 21 22 23 24 by a ound 10 30 29 28 27 26 25 11 12 31 32 33 34 35 36

Additional historical data on back

B. Description of corner evidence found and/or method applied in restoring or reestablishing corner:

Found 3/4" iron pipe. Fit witnesses by Boss, C.H.M.P., Hughes, and Shellenbarger

C. Description of monument for corner and accessories established to perpetuate locating the position of the corner:

S.E. COR. SEC 32 T4N-R4E

 $\hat{R}_{t,t,s}$ 

-Surveyor's Michigan License No.


'Set 1 1/4" x 36" Breakaway iron pipe with brass cap (Liv. Co. Mon. Cor.) 40' west of intersection of centerline Allen & burkhart

\$50°E 108.53' Spike N/S 20" Oak \$43°W 78.30' Spike NE/S 18" Twin Maple \$77°W 99.00' Spike W/S 12" Elm N63°W 80.45' Spike NE/S 24" Cherry

ENGINEER 11495

Date <u>July 5, 1995</u>

FORM APPROVED BY MICHIGAN STATE BOARD OF PROFESSIONAL SURVEYORS, JAN. 28, 1971 REVISED MAY 14, 1975 REVISED JAN., 1983

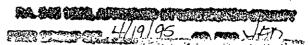



EDWARD E. ANDERSON, P.S., P.E. RICHARD F. FRANK, P.S. BRIAN R. SHALTZ, C.S.T.

Members of:
Michigan Society of Professional Surveyors
American Congress on Surveying and Mapping
American Society of Civil Engineers

401 S. Leroy St. Fenton, Michigan 48430-2164 - (313) 629-8974 FAX (313) 629-9069

SUMMARY

April 10, 1995

E-13 S.E. CORNER SECTION 32, T4N-R4E, COHOCTAH TOWNSHIP, LIVINGSTON COUNTY, MICHIGAN.

Found 3/4" iron pipe 6' north and 40' west of the intersection of the centerlines of Allen and Burkhart roads. The centerline of Burkhart Road to the north extended to the south intersections the centerline of Allen Road 40'-west of the intersections of Allen and Burkhart Roads.

Checked and measured to witnesses we found. Found 2 of 3 of Boss witnesses and they checked, Page 11 this dossier. Found 3 of 4 of C.H.M.P. witnesses and they checked, Pages 12 and 13 this dossier. Found 3 of 4 Hughes witnesses and they checked, Page 16 this dossier. Found 3 of 4 of Shellenbarger witnesses and they checked, Pages 17 and 19 this dossier.

Found 3/4" pipe 19.45 east of the S.E. corner of said Section 32, which checked with the distance to the N.E. corner of Section 5, T3N-R4E as shown on Clay Gordon survey, Page 3 this dossier. The centerline of Burkhart Road to the south extended to the north falls 115 - east of the intersection of Allen and Burkhart Roads.

Found a 1/2" rerod 16.50' east of the S.E. corner of said Section 32, which is apparently a stake that was set on the east line of the Road R.O.W. in Section 33.

Distance from the S.E. corner to the S 1/4 corner of said Section 32 is 2642.12' on Shellenbarger survey, page 18, this dossier.

Distance from S.E. corner to the East 1/4 corner of Section 32 is 2659.42' on C.H.M.P. survey, Page 12 this dossier, and 2658.99' on Hughes survey, Page 14 this dossier and 2658.83' on Shellenbarger survey, Page 18 this dossier.

Made a clean sweep of the immediate area and found no additional corners or irons.

Gravel roads running north, east and west, and a gravel road running south about 40' east of the Section Corner. (North and south road is Burkhart, gravel, and the east and west road is Allen.Road, gravel).

Roads rising to the north and west, and flat to the southeast.

Terrain is wooded in all directions. House to the N.E.

Good location for G.P.S.

Came to the conclusion that the 3/4" pipe we found is the correct S.E. corner of said Section 32.

Edward E. Anderson PS#1149°

Ark. tural, Construction, \_\_\_erty and Drainage veys

Civil Engineering \* Land and Site Planning \* Mortgage Inspection Reports