

REMONUMENTATION CORNER UNDER ACT 345, MICHIGAN PUBLIC ACTS OF 1990

LAND CORNER RECORDATION CERTIFICATE
Filing Requirement of Act 74, Mich. P.A. 1970

For corners in

LIVINGSTON
 (County)

Located In:

Corner Code #

4N 4E

G-11

- | | | | | | |
|------------------------------------|---|-------|---|-------|-------|
| 1. Public Land Survey | T | _____ | R | _____ | _____ |
| | T | _____ | R | _____ | _____ |
| | T | _____ | R | _____ | _____ |
| | T | _____ | R | _____ | _____ |
| 2. Property Controlling in Section | S | _____ | T | _____ | R |
| | S | _____ | T | _____ | R |
| 3. Miscellaneous Property in Sec. | S | _____ | T | _____ | R |
| | S | _____ | T | _____ | R |

NOV 10 8 15 AM '94
 NANCY HAVILAND
 REGISTER OF DEEDS
 LIVINGSTON COUNTY, MI
 48843

FILED

L.S.C. #283m
 Register of Deeds Stamp & File Number

4. Lot No. _____, Recorded Plat _____
5. Private Claims _____

	A	B	C	D	E	F	G	H	I	J	K	L	M
2	6	5	4	3	2	1							
3													
4	7	8	9	10	11	12							
5													
6	18	17	16	15	14	13							
7													
8	19	20	21	22	23	24							
9													
10	30	29	28	27	26	25							
11													
12	31	32	33	34	35	36							
13													


Donald G. Richards, in a field survey on September 28th, 1994

do hereby certify that under requirements of P.A. 74, Michigan P.A. of 1970, the corner points mentioned in lines 1 and 2 above were in conformance with regulations and rules therefore as required in the current manual of survey instructions of the United States Department of the Interior, Bureau of Land Management or by a decree of a Court of Law and/or that the corner points mentioned in lines 3, 4 and 5 above were in conformance with the rules of the Michigan Board of Land Surveyors or by a Decree of a Court of Law; established, re-established, monumented, re-monumented, recovered, found as expressed below:

NOTE: Not more than 4 corners, all in the same town and range, may be recorded on this certificate.

A. Description of original monument and accessories and/or subsequent restoration:
 "North between Sections 33 & 34 80.00 (chains) set post corner to Sections 27, 28, 33, & 34
 a White Oak 15 N 2 W 27
 a White Oak 12 S 70 W 43"
 Sylvester Sibley, June 13th, 1823

B. Description of corner evidence found and/or method applied in restoring or reestablishing corner:
 Found 1/2" rerod w/cap no. 13574
 (see reverse side for research and investigation summary)

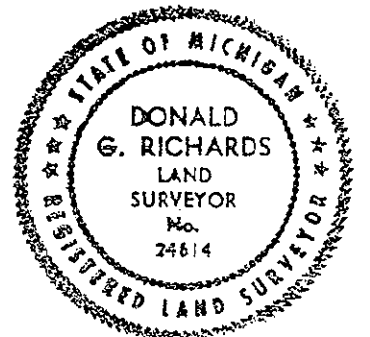

C. Description of monument for corner and accessories established to perpetuate locating the position of the corner:
 Reset with 1 1/4" x 36" iron pipe w/brass cap stamped "Livingston County Monumentation Corner" and "PS 24614"
 S 70 W 25.31' nail/tag* in north side 16" oak
 S 30 E 65.66' nail/tag* in west side 49" oak
 N 80 E 57.70' nail/tag* in south side 31" oak
 N 15 E 43.58' nail/tag* in west side 25" maple

*tags read "Livingston County Survey Witness" and are stamped "24614"

(approved by peer group 10-19-94)

[Handwritten Signature]

Donald G. Richards

Date October 20, 1994

Surveyor's Michigan License No. 24614

COHOCTAH G-11

A wood post denoting this section corner was first set June 13th, 1823, by Deputy Surveyor Sylvester Sibley. County Surveyors records dating to 1878 provide a witness for this point but fail to identify the corner material.

In the modern era, this section corner was recorded early in 1974 by Oscar Boss. Certified surveys by Charles E. Garlock in 1977, Darrell D. Hughes in 1988, and Gary Boss in 1991 utilize the same three ties to witness the corner.

On September 28th, 1994, fieldcrews recovered this point as a 1/2" rerod with cap number 13574. There are remnants of old wire fence to the south, and a some indication of a tree line to the west but in the other directions there is no evidence of occupation. All three witnesses on Oscar Boss's PA 74 document, LSC 800, are still identifiable in the field although two of the witness nails in trees have been covered by bark growth.

The distances from this section corner to east to quarter corner H-11 measures within 0.02' of the line as measured by Garlock in 1974 and 1987, and by Boss in 1991. To the south, the distance to quarter corner G-12 checked within 4 inches of the same line as reported by Hughes in 1988.

Donald G. Richards, PS 24614
October 4, 1994
Approved October 19, 1994