

MAR 17 2000

FILED

LAND CORNER RECORDATION CERTIFICATE

Filing Requirement of Act 74, Mich. P.A. 1970

1999 SEP 10 A 9:05

SECTION

corners in

9-

NANCY HAVILAND REGISTER OF DEEDS LIVINGSTON COUNTY, MI. 48843

Livingston Located In: Corner Code #

Public Land Survey T 4N R 4E H-9
Property Controlling in Section S T R
Miscellaneous S T R
Property in Sec. S T R

LSC# 1058m Register of Deeds Stamp & File Number

Lot No. Recorded Plat Private Claims

Grid table with columns A-M and rows 1-13. Contains numbers 1-36 and a circled '3' in row 9, column G.

John H. Rauser, P.S., in a field survey on June 19 99 hereby certify that under requirements of P.A. 74, Michigan P.A. of 1970, the corner points mentioned in lines 1 and 2 above were in conformance with regulations and rules therefore as required in the current manual of survey instructions of the United States Department of the Interior, Bureau of Land Management or by a decree of a Court of Law and/or that the corner points mentioned in lines 3, 4 and 5 above were in conformance with the rules of the Michigan Board of Land Surveyors or by a Decree of a Court of Law; established, re-established, monumented, re-monumented, recovered, found as expressed below:

NOTE: Not more than 2 corners, all in the same town and range, may be recorded on this certificate.

Description of original monument and accessories and/or subsequent restoration:

Common 1/4 Corner, Sections 22 & 27, T4N-R4E

1823 Wood post placed by Sylvester Sibley, D.S. S32 1/2W 2.22ch (146.52') 16" W. Oak N77E 1.10ch (72.60') 15" W. Oak

(Additional information on back)

Description of corner evidence found and/or method applied in restoring or reestablishing corner:


Common 1/4 Corner, Sections 22 & 27, T4N-R4E

Found what appears to be a 1" "T" iron fence post, 2'+ West of the physical center line of gravel road, in line with old fences East and West.

Description of monument for corner and accessories established to perpetuate locating the position of the corner:

Common 1/4 Corner, Sections 22 & 27, T4N-R4E

Standard Livingston County Remon breakaway monument set 0.5' below existing gravel grade N76E 31.24' Set spike with Livingston County Remon tag in N fc 40" Oak N20E 133.75' Set spike with Livingston County Remon tag in W/ly fc PP S80W 45.50' Set spike with Livingston County Remon tag in S fc 10" Ash S30W 98.55' Set spike with Livingston County Remon tag in NE fc 18" Oak

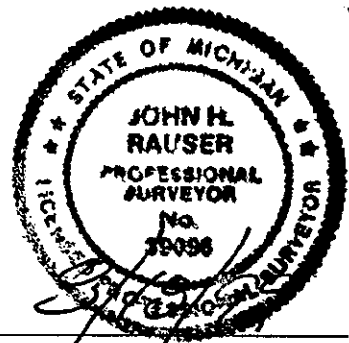

Handwritten signature of John H. Rauser

Signed by Surveyor's Michigan License No. 39096

Date