

MAR 17 2000

FILED

SECTION

LAND CORNER RECORDATION CERTIFICATE
Filing Requirement of Act 74, Mich. P.A. 1970

1999 SEP 10 A 9:05

NANCY HAVILAND
REGISTER OF DEEDS
LIVINGSTON COUNTY, MI.
48843

For corners in

9-

Livingston Located In: Corner Code #
(County)

- 1. Public Land Survey T 4N R 4E J-9
T _____ R _____
- 2. Property Controlling S _____ T _____ R _____
in Section S _____ T _____ R _____
- 3. Miscellaneous S _____ T _____ R _____
Property in Sec. S _____ T _____ R _____

LSC# 1061m
Register of Deeds Stamp & File Number

- 4. Lot No. _____, Recorded Plat _____
- 5. Private Claims _____

	A	B	C	D	E	F	G	H	I	J	K	L	M
1													
2	6	5	4	3	2	1							
3													
4	7	8	9	10	11	12							
5													
6	18	17	16	15	14	13							
7													
8	19	20	21	22	23	24							
9													
10	30	29	28	27	26	25							
11													
12	31	32	33	34	35	36							
13													

John H. Rauser, P.S., in a field survey on June 1999
do hereby certify that under requirements of P.A. 74, Michigan P.A. of 1970, the corner points mentioned
in lines 1 and 2 above were in conformance with regulations and rules therefore as required in the
current manual of survey instructions of the United States Department of the Interior, Bureau of Land
Management or by a decree of a Court of Law and/or that the corner points mentioned in lines 3, 4 and 5
above were in conformance with the rules of the Michigan Board of Land Surveyors or by a Decree of a
Court of Law; established, re-established, monumented, re-monumented, recovered, found as
expressed below:

NOTE: Not more than 2 corners, all in the same town and range, may be recorded on this certificate.

1. Description of original monument and accessories and/or subsequent restoration:

1-9 Common 1/4 Corner, Sections 23 & 26, T4N-R4E
1823 Wood post placed by Sylvester Sibley, D.S.
N26W 31lks (20.46') 9" W. Oak
S60W 22lks (14.52') 8" W. Oak


(Additional information on back)

3. Description of corner evidence found and/or method applied in restoring or reestablishing corner:

-9 Common 1/4 Corner, Sections 23 & 26, T4N-R4E
Found 1/2" re-rod, in monument box, 1'+ West of the physical centerline of Oak Grove Road, 49'+ South of a field entrance to the West and a driveway to the East.

2. Description of monument for corner and accessories established to perpetuate locating the position of the corner:

-9 Common 1/4 Corner, Sections 23 & 26, T4N-R4E
Standard Livingston County Remon breakaway monument in the existing monument box
N40W 97.52' PP
N55E 63.52' PP
S63W 37.27' Spike & tag in 24" Maple
S88E 35.56' Spike & tag in 24" Locust
N65E 41.3' Spike & tag in NE fc 30" Locust
N39W 54.62' Spike in N-side RR tie fence post

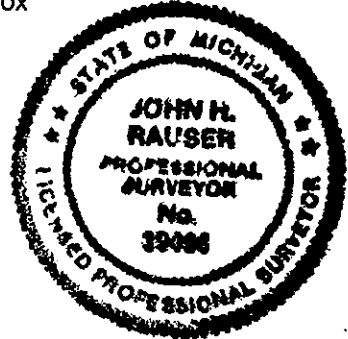

Signed by John H. Rauser Date _____
Surveyor's Michigan License No. 39096