SURVEY & REMONUMENTATION

FEB 2 5 1999

SECTION

1998 REMONUMENTATION PROGRAM
LAND CORNER RECORDATION CERTIFICATE
Filing Requirement of Act 74, Mich. P.A. 1970

FILED

1998 OCT 14 P 2:11

NANCY HAVILAND
REGISTER OF DEEDS
LIVINGSTON COUNTY, MI.
48843

9

LSC 907M

Register of Deeds Stamp & File Number

For corners in

Livingston (County) Located In: Corner Code #

1. Public Land Survey T 4N R4E K-7
   T___ R___ ___
2. Property Controlling S___ T___ R___ ___
   in Section S___ T___ R___ ___
3. Miscellaneous S___ T___ R___ ___
   Property in Sec. S___ T___ R___ ___

4. Lot No. ____, Recorded Plat _____
5. Private Claims _____

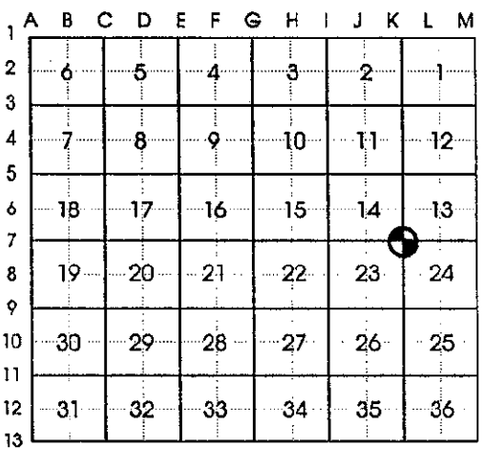

I, John H. Rauser, P.S., in a field survey on September 1998 do hereby certify that under requirements of P.A. 74, Michigan P.A. of 1970, the corner points mentioned in lines 1 and 2 above were in conformance with regulations and rules therefore as required in the current manual of survey instructions of the United States Department of the Interior, Bureau of Land Management or by a decree of a Court of Law and/or that the corner points mentioned in lines 3, 4 and 5 above were in conformance with the rules of the Michigan Board of Land Surveyors or by a Decree of a Court of Law; established, re-established, monumented, re-monumented, recovered, found as expressed below:

NOTE: **Not more than 2 corners, all in the same town and range, may be recorded on this certificate.**

A. Description of original monument and accessories and/or subsequent restoration:

K-7 Common Section Corner, Sections 13, 14, 23, & 24, T4N-R4E, Cohoctah Township, Livingston County

1823 Wood post set by John Mullett, D.S.: W. Oak 22" N27.5W 7 lks
W. Oak 18" S61.5E 43lks

(Additional information on back)

B. Description of corner evidence found and/or method applied in restoring or reestablishing corner:

K-7 Common Section Corner, Sections 13, 14, 23, & 24, T4N-R4E, Cohoctah Township, Livingston County

Found re-rod with cap #13574 (Oscar Boss) in centerline of road to the North and West.

C. Description of monument for corner and accessories established to perpetuate locating the position of the corner:

K-7 Common Section Corner, Sections 13, 14, 23, & 24, T4N-R4E, Cohoctah Township, Livingston County

Set standard Livingston County Remon iron pipe with brass cap.

S11E	5.38'	Set remon tag above fnd nail in W fc 48" Oak
S82W	22.60'	Set remon tag above fnd nail in N fc guy pole
N15E	24.04'	Set remon tag above fnd nail in W fc guy pole
S75W	49.41'	Set remon tag above fnd nail in N fc 36" Oak
N60E	32.42'	Set remon tag in NW fc 12" Ash

Signed by John H. Rauser Date 9/9/98

Surveyor's Michigan License No. 39096

STATE OF MICHIGAN JOHN H. RAUSER PROFESSIONAL SURVEYOR No. 39096 LICENSED PROFESSIONAL

FORM APPROVED BY MICHIGAN STATE BOARD OF LAND SURVEYORS, JAN. 28, 1971
REVISED MAY 14, 1975
REVISED JAN., 1983
ADAPTED FOR WORD PROCESSING MARCH, 1993

P.A. 345 1990, APPROVED BY LIVINGSTON COUNTY

PEER GROUP ON 6-3-98 CO. REP JED