

1993

FILED

9-

COMMISSION

LAND CORNER RECORDATION CERTIFICATE

Filing Requirement of Act 74, Mich. P.A. 1970

DEC 22 9 25 AM '93

For corners in

LIVINGSTON

(County)

Located In:

Corner Code #

1. Public Land Survey

T 4N R 4E

L-13

T R

T R

T R

2. Property Controlling in Section

S T R

S T R

3. Miscellaneous Property in Sec.

S T R

S T R

NANCY HAVILAND REGISTER OF DEEDS LIVINGSTON COUNTY, MI 48043

L.S.C.# 66m

Register of Deeds Stamp & File Number

4. Lot No. , Recorded Plat

5. Private Claims

	A	B	C	D	E	F	G	H	I	J	K	L	M
2	6		5		4		3		2				
3													
4	7		8		9		10		11		12		
5													
6	18		17		16		15		14		13		
7													
8	19		20		21		22		23		24		
9													
10	30		29		28		27		26		25		
11													
12	31		32		33		34		35		36		
13													

Donald G. Richards in a field survey on October 19 1993

do hereby certify that under requirements of P.A. 74, Michigan P.A. of 1970, the corner points mentioned in lines 1 and 2 above were in conformance with regulations and rules therefore as required in the current manual of survey instructions of the United States Department of the Interior, Bureau of Land Management or by a decree of a Court of Law and/or that the corner points mentioned in lines 3, 4 and 5 above were in conformance with the rules of the Michigan Board of Land Surveyors or by a Decree of a Court of Law; established, re-established, monumented, re-monumented, recovered, found as expressed below:

NOTE: Not more than 4 corners, all in the same town and range, may be recorded on this certificate.

A. Description of original monument and accessories and/or subsequent restoration:


John Mullett, April 12th, 1823
"Set Post 1/4 Section Corner
Black Oak 15 N 84 E 2.04 (chains)
Black Oak 8 N 8 W 1.57"

B. Description of corner evidence found and/or method applied in restoring or reestablishing corner:

Found 1/2" Iron Rod with cap No. 17022 6' south of centerline of E/W gravel road and fitting occupation to the north marked by old fenceline (see reverse side for research and investigation summary)

C. Description of monument for corner and accessories established to perpetuate locating the position of the corner:

Re-set with 1 1/4" x 36" iron pipe w/brass cap stamped "Livingston County Remonumentation Corner"
S 55 W 51.59' nail/LCWT\* in N face 20" Oak
N 05 E 91.38' nail/LCWT in W face 9" Cherry
N 45 E 54.62' nail/LCWT in NW face 15" Elm
S 45 E 37.14' nail/LCWT in SW face twin 15"-18" Oak
EAST 37.16 quarter corner L-1, T3N-R4E
(\* Livingston County Witness Tag)

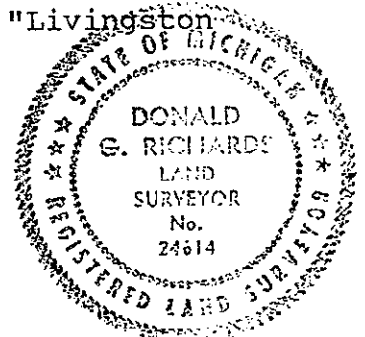

Signed by DONALD G. RICHARDS

[Handwritten signature of Donald G. Richards]

Date December 10, 1993

Surveyor's Michigan License No. 24614

APPROVED by Livingston County Monumentation Peer Group 11-23-93

COHOCTAH L-13

On April 12th, 1823 a wood post was set by John Mullett to mark this standard corner. County Surveyors I. Teller in 1878 and M. W. Bullock in 1905 apparently recovered this corner and witnessed it. However, records furnished us for this report do not identify the material marking the corner.

In the modern era, Boss'78 identifies the point as a 1/2" iron lying 37.15' west of the closing corner for the township to the south and this information is also contained on Boss'90 surveys. This identification and the closing corner ties are more or less confirmed by Garlock surveys in 1990.

On October 19, 1993, the fieldcrew recovered a 1/2" iron with cap 17022 and three witness ties dating to Boss'78. Additionally, one other witness for the corner from Boss'90 was identified, and the distance East to the closing corner is consistent with Boss'78. Corner L-13 is 6' South of the centerline of a East and West running gravel road and fits an occupied fenceline to the North, recently surveyed and marked. Closing corner L-1 fall 4' West of an old wire fence (lying down) running to the South. It also is roughly 5' South of the centerline of the road.

Relative to the section corners lying half-mile east or west of this point, the observed distances check within a tenth of a foot of the corresponding distances shown on surveys by Boss '78, '87, and '90, and by Garlock'90.

Donald G. Richards, PS 24614  
November 18, 1993