

**SURVEY & REMONUMENTATION**

FEB 24 1998

SECTION

**LAND CORNER RECORDATION CERTIFICATE**  
Filing Requirement of Act 74, Mich. P.A. 1970

9-  
**FILED**

For corners in

LIVINGSTON

Located In:

Corner Code #

(County)

1. Public Land Survey

T 4N R 5E B-13

T \_\_\_\_\_ R \_\_\_\_\_ \_\_\_\_\_

T \_\_\_\_\_ R \_\_\_\_\_ \_\_\_\_\_

T \_\_\_\_\_ R \_\_\_\_\_ \_\_\_\_\_

2. Property Controlling in Section

S \_\_\_\_\_ T \_\_\_\_\_ R \_\_\_\_\_

S \_\_\_\_\_ T \_\_\_\_\_ R \_\_\_\_\_

3. Miscellaneous Property in Sec.

S \_\_\_\_\_ T \_\_\_\_\_ R \_\_\_\_\_

S \_\_\_\_\_ T \_\_\_\_\_ R \_\_\_\_\_

1997 SEP 23 A 10:18

NANCY HAVILAND  
REGISTER OF DEEDS  
LIVINGSTON COUNTY, MI.  
48843

L.S.C.#699m

Register of Deeds Stamp & File Number

4. Lot No. \_\_\_\_\_, Recorded Plat \_\_\_\_\_

5. Private Claims \_\_\_\_\_

I, Jack K. Smith, in a field survey on July 20, 1997 do hereby state that under requirements of P.A. 74, Michigan P.A. of 1970, the corner points mentioned in lines 1 and 2 above were in conformance with regulations and rules therefore as required in the current manual of survey instructions of the United States Department of the Interior, Bureau of Land Management or by a decree of a Court of Law and/or that the corner points mentioned in lines 3, 4 and 5 above were in conformance with the rules of the Michigan Board of Land Surveyors or by a Decree of a Court of Law; established, re-established, monumented, recovered, found as expressed below:

NOTE: Not more than 2 corners, all in the same town and range, may be recorded on this certificate.

A	B	C	D	E	F	G	H	I	J	K	L	M
1												
2	6		5		4		3		2		1	
3												
4	7		8		9		10		11		12	
5												
6	18		17		16		15		14		13	
7												
8	19		20		21		22		23		24	
9												
10	30		29		28		27		26		25	
11												
12	31		32		33		34		35		36	
13												

A. Description of original monument and accessories and/or subsequent restoration:

B-13 The South 1/4 Corner of Section 31, Deerfield Township was set by John Mullett for the GLO in 1823.


The original witnesses are:

B Oak 12" N53°E 9 lk (5.9')  
B Oak 13" N88°W 32 lk (21.1')

NOTE: NONE OF THE ORIGINAL WITNESSES COULD BE FOUND OR PERPETUATED. SEE THE BACK OF THIS SHEET FOR ADDITIONAL HISTORICAL DATA.

B. Description of corner evidence found and/or method applied in restoring or reestablishing corner:

B-13 Found 1/2" re-rod on the centerline of Allen Road (grave) OF MICHIGAN

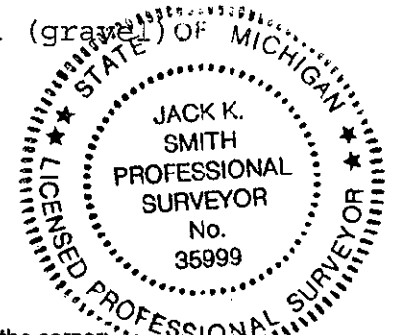

C. Description of monument for corner and accessories established to perpetuate locating the position of the corner:

B-13 South 1/4 Corner, Section 31, T4N, R5E - Set 1 1/4" x 30" steel pipe with 6" break-off section and brass cap marked as "Livingston County Remonumentation Corner".

N78°E Set nail/tag in South side 20" Hickory 62.13'  
S40°E Set nail/tag in NE side 21" Ash 43.65'  
S57°W Set nail/tag in NW side 12" Maple 51.07'  
N58°W Set nail/tag in SW side 18" Hickory 49.80'

Signed by [Signature]

Date July 20, 1997

Surveyor's Michigan License No. 35999

July 12, 1997

B-13 T4N - R5E: SOUTH 1/4 CORNER, SECTION 31, DEERFIELD TOWNSHIP

**MONUMENTATION**

B-13 was set by John Mullett for the GLO in 1823. This corner is currently marked by a 1/2" re-rod set by Karol Piotrowski (LSC #881) in 1974.

**MEASUREMENTS**

Current measure is 2624.80 feet to the east and 2453.58 feet to the west. Post 1970 measures to east and west compare well. The early measures of Bullock (1875) would indicate the possibility of a second position 10-20 feet westerly of the currently marked position but no evidence could be found to support upsetting the present location. The closing corner falls 195.30 feet east of B-13 (GLO computes to 108.9 feet).

**OCCUPATION**


B-13 falls on the centerline of Allen Road (gravel). There are a few trees on line to the north with remains of fence. A sweep of the area around the corner with a magnetic locator did not reveal any alternate corner positions. This corner is partially masked for GPS and will require careful pre-mission planning.

**RECORDATION**

There is an Act 74 filed by Karol Piotrowski from 1974 when the current monumentation was set. The corner has been shown on 5 Act 132s.

**SUMMARY**

The current location of the corner has been used for numerous surveys in the area and no other position has been used that I could find. Considering the 20 plus years of continuous use I recommend that the existing 1/2" iron be replaced with a Livingston County Remonumentation pipe and cap.

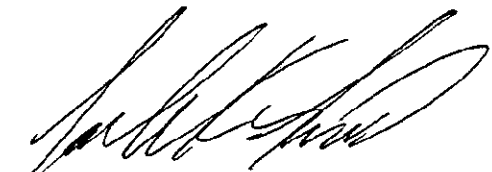  
Jack K. Smith, PS  
Desine Inc.

