

SURVEY & REMONUMENTATION

FEB 24 1998

LAND CORNER RECORDATION CERTIFICATE Filing Requirement of Act 74, Mich. P.A. 1970

9- FILED

For corners in SECTION

LIVINGSTON
(County)

Located In:

Corner Code #

1. Public Land Survey

T 4N R 5E D-13

T ___ R ___

T ___ R ___

T ___ R ___

2. Property Controlling in Section

S ___ T ___ R ___

S ___ T ___ R ___

3. Miscellaneous Property in Sec.

S ___ T ___ R ___

S ___ T ___ R ___

1997 SEP 23 A 10: 18

NANCY HAVILAND
REGISTER OF DEEDS
LIVINGSTON COUNTY, MI.
48843

L.S.C.#701m

Register of Deeds Stamp & File Number

4. Lot No. _____, Recorded Plat _____

5. Private Claims _____

I, Jack K. Smith, in a field survey on July 20, 1997 do hereby state that under requirements of P.A. 74, Michigan P.A. of 1970, the corner points mentioned in lines 1 and 2 above were in conformance with regulations and rules therefore as required in the current manual of survey instructions of the United States Department of the Interior, Bureau of Land Management or by a decree of a Court of Law and /or that the corner points mentioned in lines 3, 4 and 5 above were in conformance with the rules of the Michigan Board of Land Surveyors or by a Decree of a Court of Law; established, re-established, monumented, recovered, found as expressed below:

NOTE: Not more than 2 corners, all in the same town and range, may be recorded on this certificate.

	A	B	C	D	E	F	G	H	I	J	K	L	M
1													
2	6		5		4		3		2		1		
3													
4	7		8		9		10		11		12		
5													
6	16		17		16		15		14		13		
7													
8	19		20		21		22		23		24		
9													
10	30		29		28		27		26		25		
11													
12	31		32		33		34		35		36		
13													

A. Description of original monument and accessories and/or subsequent restoration:

D-13 The South 1/4 Corner of Section 32, Deerfield Township was set by John Mullett for the GLO in 1823.


The original witnesses are:

B Oak 16" N06°E 11 lk (7.3')
W Oak 14" N69 1/2°W 58 lk (38.3')

NOTE: NONE OF THE ORIGINAL WITNESSES COULD BE FOUND OR PERPETUATED. SEE THE BACK OF THIS SHEET FOR ADDITIONAL HISTORICAL DATA.

B. Description of corner evidence found and/or method applied in restoring or reestablishing corner:

D-13 Found 1/2" re-rod on the centerline of Allen Road (gravel)

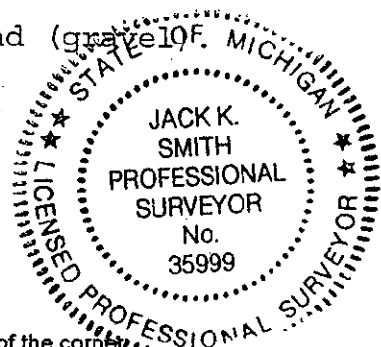

C. Description of monument for corner and accessories established to perpetuate locating the position of the corner:

D-13 South 1/4 Corner, Section 32, T4N, R5E - Set 1 1/4" x 30" steel pipe with 6" break-off section and brass cap marked as "Livingston County Remonumentation Corner".

S53°W Set nail/tag in NW side 18" Maple 40.85'
N74°W Set nail/tag in South side 26" Maple 75.79'
S04°W Set nail/tag in East side 16" Ash 30.05'
S58°E Set nail/tag in North side Quad 12" Ash 50.63'

Signed by [Signature]
Surveyor's Michigan License No. 35999

Date July 20, 1997

July 12, 1997

D-13 T4N - R5E: SOUTH 1/4 CORNER, SECTION 32, DEERFIELD TOWNSHIP

MONUMENTATION

D-13 was set by John Mullett for the GLO in 1823. This corner is currently marked by a 1/2" re-rod set by Charles Garlock in 1971. The corner was placed by splitting roadside fences and using occupation to the north. The corner is about 30 feet east of a field access drive to the south. No other marker could be found near this location.

MEASUREMENTS

Current measure is 2643.71 feet to the west and 2647.49 feet to the east. Post 1978 measures to east and west compare well. The early measures of Bullock (1875) to the east and west are consistently short as compared to current.

OCCUPATION


The corner falls in the centerline of Allen Road (gravel) and is on occupation (trees and fence) to the north. A thorough sweep of the area around the corner with a magnetic locator did not reveal any alternate corner positions. This corner is masked for GPS and can only be used with careful pre-mission planning.

RECORDATION

There are Act 74s filed by Garlock (1971) and Boss (1978) on this corner. The corner has been shown on 5 Act 132s.

SUMMARY

The current location of the corner has been used for numerous surveys in the area and no other position has been used that I could find. I recommend that the existing 1/2" iron be replaced with a Livingston County Remonumentation pipe and cap in the present location.


Jack K. Smith, PS
Desine Inc.

