SURVEY & MONUMENTATION

MAR 17 2000

SECTION

FILED

LAND CORNER RECORDATION CERTIFICATE
Filing Requirement of Act 74, Mich. P.A. 1970

9'

1999 NOV 22 A 10: 08

NANCY HAVILAND
REGISTER OF DEEDS
LIVINGSTON COUNTY, MI.
48843

LSC# 1090m

Register of Deeds Stamp & File Number

For corners in

LIVINGSTON (County) Located in: Corner Code #

1. Public Land Survey		T 4N	R 5E	I-06
		T	R	
		T	R	
		T	R	
2. Property Controlling	S	T	R	
in Section	S	T	R	
3. Miscellaneous	S	T	R	
Property in Sec.	S	T	R	

4. Lot No. _____ , Recorded Plat _____

5. Private Claims _____

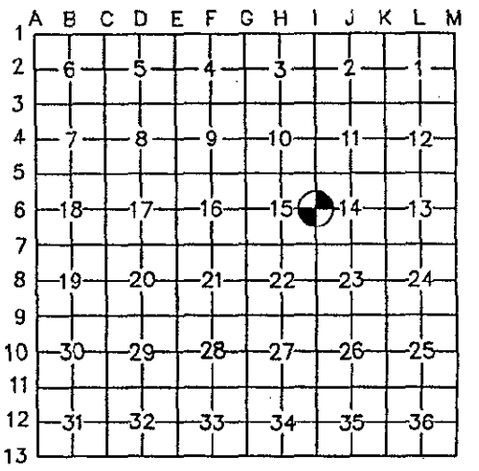

I, MARY A. BARNWELL, in a field survey on SEPTEMBER 29, 1999 do hereby state that under requirements of P.A. 74, Michigan P.A. of 1970, the corner points mentioned in lines 1 and 2 above were in conformance with regulations and rules therefore as required in the current manual of survey instructions of the United States Department of the Interior, Bureau of Land Management or by a decree of a Court of Law and /or that the corner points mentioned in lines 3, 4 and 5 above were in conformance with the rules of the Michigan Board of Land Surveyors or by a Decree of a Court of Law; established, re-established, monumented, recovered, found as expressed below:

NOTE: Not more than 2 corners, all in the same town and range, may be recorded on this certificate.

A. Description of original monument and accessories and/or subsequent restoration:

I-06 Deerfield Township was set by the GLO in 1823.
The original witnesses are:
White Oak 8" N 66° W 19 Links (12.5')
White Oak 8" S 08° E 43 Links (28.4')

NOTE: None of the original witnesses could be found or perpetuated.
See the back of this sheet for additional historical data.

B. Description of corner evidence found and/or method applied in restoring or reestablishing corner:

I-06 Found P.K. Nail at the centerline of Argentine Road (asphalt surface running North/South) - old tree line to the East - wooded to the West

C. Description of monument for corner and accessories established to perpetuate locating the position of the corner:

I-06 West 1/4 Corner, Section 14, T4N, R5E - Reset P.K. Nail with 36" x 1 1/4" steel breakaway pipe with Brass Cap marked as "Livingston County Monumentation Corner" in a new Monument Box.

East Set Nail/Remon Washer N/S 22" Oak 27.86'
N 40° E Set Nail/Remon Washer SE/S Twin 20" Ash 38.27'
N 69° W Set Nail/Remon Washer NE/S 16" Ash 30.88'
S 16° W Set Nail/Remon Washer E/S 18" Oak 102.06'

Signed by [signature] Date 11-4-99

Surveyor's Michigan License No. 33971

STATE OF MICHIGAN MARY A. BARNWELL PROFESSIONAL SURVEYOR No. 33971 LICENSED PROFESSIONAL SURVEYOR

P.A. 345 1990, APPROVED BY LIVINGSTON COUNTY

PEER GROUP ON 8-4-99 CO. REP JEL

FORM APPROVED BY MICHIGAN STATE BOARD OF PROFESSIONAL SURVEYORS, JAN. 28, 1971
REVISED MAY 14, 1975
REVISED JAN., 1983
REVISED OCT., 1995