MAR 1 7 2000

SECTION

FILED

LAND CORNER RECORDATION CERTIFICATE
Filing Requirement of Act 74, Mich. P.A. 1970

9'

1999 NOV 22 A 10: 08

NANCY HAVILAND
REGISTER OF DEEDS
LIVINGSTON COUNTY, MI.
48843

LSC# 1091m

Register of Deeds Stamp & File Number

For corners in

LIVINGSTON (County) Located In: Corner Code #

1. Public Land Survey		T 4N	R 5E	I-07
		T	R	
		T	R	
		T	R	
2. Property Controlling in Section	S	T	R	
	S	T	R	
3. Miscellaneous Property in Sec.	S	T	R	
	S	T	R	

4. Lot No. _____, Recorded Plat _____
5. Privat Claims _____

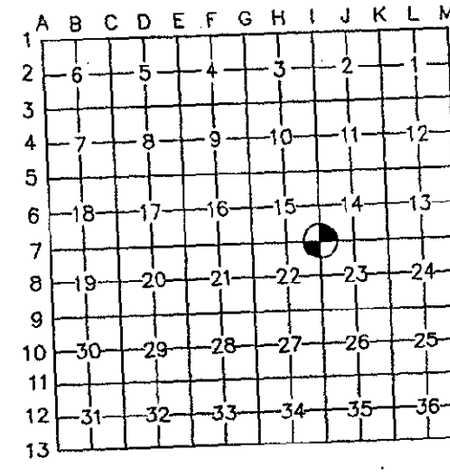

I, MARY A. BARNWELL, in a field survey on SEPTEMBER 29, 1999 do hereby state that under requirements of P.A. 74, Michigan P.A. of 1970, the corner points mentioned in lines 1 and 2 above were in conformance with regulations and rules therefore as required in the current manual of survey instructions of the United States Department of the Interior, Bureau of Land Management or by a decree of a Court of Law and /or that the corner points mentioned in lines 3, 4 and 5 above were in conformance with the rules of the Michigan Board of Land Surveyors or by a Decree of a Court of Law; established, re-established, monumented, recovered, found as expressed below:

NOTE: Not more than 2 corners, all in the same town and range, may be recorded on this certificate.

A. Description of original monument and accessories and/or subsequent restoration:

I-07 Deerfield Township was set by the GLO in 1823.
The original witnesses are:
White Oak 28" N 81° E 9 Links (5.9')
White Ash 12" S 68 1/2° W 25 Links (16.5')

NOTE: None of the original witnesses could be found or perpetuated.
See the back of this sheet for additional historical data.

B. Description of corner evidence found and/or method applied in restoring or reestablishing corner:

I-07 Found 1/2" Iron Rod at the centerline intersection of Argentine Road (asphalt surface running North/South) And Center Road (asphalt surface to the West-gravel surface to the East)

C. Description of monument for corner and accessories established to perpetuate locating the position of the corner:

I-07 Northwest Corner, Section 23, T4N, R5E - Reset the 1/2" Iron Rod with 30" x 1 1/4" steel pipe with Brass Cap marked as "Livingston County Monumentation Corner" in New Monument Box

N 42°E Set Nail/Remon Washer SE/S Triple 8" Elm 51.40'
S 67° E Set Nail/Remon Washer NE/S 30" Ash 78.38'
S 26° E Set Nail/Remon Washer W/S 28" Ash 65.67'
S 51° W Set Nail/Remon Washer SE/S 28" Oak 58.79'

Signed by _____ 11-4-99

Surveyor's Michigan License No. 33971

STATE OF MICHIGAN
MARY A. BARNWELL
PROFESSIONAL SURVEYOR
No. 33971
LICENSED PROFESSIONAL SURVEYOR

P.A. 345 1990, APPROVED BY LIVINGSTON COUNTY

PEER GROUP ON 8-4-99 CO. REP JED

FORM APPROVED BY MICHIGAN STATE BOARD OF PROFESSIONAL SURVEYORS, JAN. 28, 1971
REVISED MAY 14, 1975
REVISED JAN., 1983
REVISED OCT., 1995