SURVEY &
RECORDATION
MAR 17 2000
SECTION

LAND CORNER RECORDATION CERTIFICATE
Filing Requirement of Act 74, Mich. P.A. 1970

FILED
1999 NOV 22 A 10: 08
NANCY HAVILAND
REGISTER OF DEEDS
LIVINGSTON COUNTY, MI.
48843
LSC# 1097m
Register of Deeds Stamp & File Number

For corners in

LIVINGSTON (County) Located In: Corner Code #

1. Public Land Survey		T 4N	R 5E	J-09
		T	R	
		T	R	
		T	R	
2. Property Controlling in Section	S	T	R	
	S	T	R	
3. Miscellaneous Property in Sec.	S	T	R	
	S	T	R	

4. Lot No. _____ , Recorded Plat _____
5. Private Claims _____

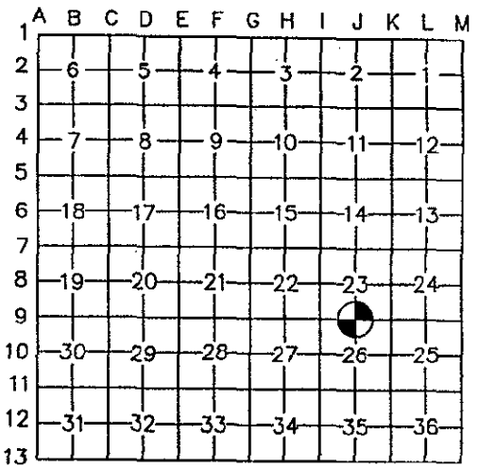

I, MARY A. BARNWELL, *in a field survey on* SEPTEMBER 29, 1999 do hereby state that under requirements of P.A. 74, Michigan P.A. of 1970, the corner points mentioned in lines 1 and 2 above were in conformance with regulations and rules therefore as required in the current manual of survey instructions of the United States Department of the Interior, Bureau of Land Management or by a decree of a Court of Law and /or that the corner points mentioned in lines 3, 4 and 5 above were in conformance with the rules of the Michigan Board of Land Surveyors or by a Decree of a Court of Law; established, re-established, monumented, recovered, found as expressed below:

NOTE: Not more than 2 corners, all in the same town and range, may be recorded on this certificate.

A. Description of original monument and accessories and/or subsequent restoration:

J-09 Deerfield Township was set by the GLO in 1823.
The original witnesses are:
Black Oak 14" S. 28° W. 19 Links (12.5')
Hickory N. 3° E. 15 Links (9.9')

NOTE: None of the original witnesses could be found or perpetuated.
See the back of this sheet for additional historical data.

B. Description of corner evidence found and/or method applied in restoring or reestablishing corner:

J-09 Found 1/2" Iron Rod at the centerline of Dean Road (gravel surface running East/West) - tree line To the North - old fence post approx. 100 feet South with old fence, but occupation South not well defined.

C. Description of monument for corner and accessories established to perpetuate locating the position of the corner:

J-09 North 1/4 Corner, Section 26, T4N, R5E - Reset 1/2" Iron Rod with 36" x 1 1/4" steel breakaway pipe with Brass Cap marked as "Livingston County Monumentation Corner"

N 05° E Set Nail/Remon Washer E/S 8" Hickory 33.99'
S 15° W Set Nail/Remon Washer W/S 24" Oak 24.48'
S 66° W Set Nail/Remon Washer NW/S 12" Ash 50.92'
N 52° W Set Nail/Remon Washer NE/S 8" Hickory 40.65'

STATE OF MICHIGAN
MARY A. BARNWELL
PROFESSIONAL SURVEYOR
No. 33971
LICENSED PROFESSIONAL SURVEYOR

Signed by _____ Date 11-4-99
Surveyor's Michigan License No. 33971

P.A. 345 1990, APPROVED BY LIVINGSTON COUNTY PEER GROUP ON 8-14-99 **CO. REP** JED

FORM APPROVED BY MICHIGAN STATE BOARD OF PROFESSIONAL SURVEYORS, JAN. 28, 1971
REVISED MAY 14, 1975
REVISED JAN., 1983
REVISED OCT. 1995