

9-

LAND CORNER RECORDATION CERTIFICATE  
Filing Requirement of Act 74, Mich. P.A. 1970

For corners in

|                                       |                            |               |
|---------------------------------------|----------------------------|---------------|
| <u>Livingston</u><br>(County)         | Located In:                | Corner Code # |
| 1. Public Land Survey                 | T <u>4</u> N R <u>5</u> NE | <u>K-4</u>    |
|                                       | T _____ R _____            | _____         |
|                                       | T _____ R _____            | _____         |
|                                       | T _____ R _____            | _____         |
| 2. Property Controlling<br>in Section | S _____ T _____ R _____    | _____         |
|                                       | S _____ T _____ R _____    | _____         |
| 3. Miscellaneous<br>Property in Sec.  | S _____ T _____ R _____    | _____         |
|                                       | S _____ T _____ R _____    | _____         |
| 4. Lot No. _____, Recorded Plat _____ |                            |               |
| 5. Private Claims _____               |                            |               |

FILED

1996 DEC 30 A 11:14

NANCY HAVILAND  
REGISTER OF DEEDS  
LIVINGSTON COUNTY, MI.  
48843

L.S.C. #650m  
Register of Deeds Stamp & File Number

I, Donald W. Ross, in a field survey on December 22, 1996 do hereby state that under requirements of P.A. 74, Michigan P.A. of 1970, the corner points mentioned in lines 1 and 2 above were in conformance with regulations and rules therefore as required in the current manual of survey instructions of the United States Department of the Interior, Bureau of Land Management or by a decree of a Court of Law and /or that the corner points mentioned in lines 3, 4 and 5 above were in conformance with the rules of the Michigan Board of Land Surveyors or by a Decree of a Court of Law; established, re-established, monumented, recovered, found as expressed below:

NOTE: Not more than 2 corners, all in the same town and range, may be recorded on this certificate.

|    |    |   |    |   |    |   |    |   |    |   |    |   |   |
|----|----|---|----|---|----|---|----|---|----|---|----|---|---|
|    | A  | B | C  | D | E  | F | G  | H | I  | J | K  | L | M |
| 1  |    |   |    |   |    |   |    |   |    |   |    |   |   |
| 2  | 6  |   | 5  |   | 4  |   | 3  |   | 2  |   | 1  |   |   |
| 3  |    |   |    |   |    |   |    |   |    |   |    |   |   |
| 4  | 7  |   | 8  |   | 9  |   | 10 |   | 11 |   | 12 |   |   |
| 5  |    |   |    |   |    |   |    |   |    |   |    |   |   |
| 6  | 18 |   | 17 |   | 16 |   | 15 |   | 14 |   | 13 |   |   |
| 7  |    |   |    |   |    |   |    |   |    |   |    |   |   |
| 8  | 19 |   | 20 |   | 21 |   | 22 |   | 23 |   | 24 |   |   |
| 9  |    |   |    |   |    |   |    |   |    |   |    |   |   |
| 10 | 30 |   | 29 |   | 28 |   | 27 |   | 26 |   | 25 |   |   |
| 11 |    |   |    |   |    |   |    |   |    |   |    |   |   |
| 12 | 31 |   | 32 |   | 33 |   | 34 |   | 35 |   | 36 |   |   |
| 13 |    |   |    |   |    |   |    |   |    |   |    |   |   |

A. Description of original monument and accessories and/or subsequent restoration:

K-4 The Quarter corner common to Sections 11 and 12, Deerfield Township was set by the GLO in 1823 by Hervey Parke, U.S. Deputy Surveyor.  
The original witnesses are:  
W Oak 14" dia. Bears N 67 E 50 links (33.00')  
W Oak 16" dia. Bears S 22 W 18 links (11.88')

Note: None of the original witnesses could be found of perpetuated.  
See the back of this sheet for additional historical data.

B. Description of corner evidence found and/or method applied in restoring or reestablishing corner:


K-4 Fd. 3/8" iron rod 6 feet West of the center line of Green Roads. G. Fauser witnesses same, in 1971, and all of the witnesses remain.

C. Description of monument for corner and accessories established to perpetuate locating the position of the corner:

K-4 Quarter corner common to Sections 11 and 12, T4N, R5E  
Set 30" x 1 1/4" iron pipe with a 6" x 1 1/4" Break-off and brass cap marked a "Livingston County Monument Corner".  
N 84° E Set nail and tag in S face of 26" Oak 35.68'  
S 04° E Set nail and tag in W face of 38" Oak 100.08'  
S 46° W Set nail and tag in N face of 12" Poplar 48.98'  
N 54° W Set nail and tag in NE face of 126" Oak 33.14'

Signed by \_\_\_\_\_  
Surveyor's Michigan License No. 19005

December 26, 1996

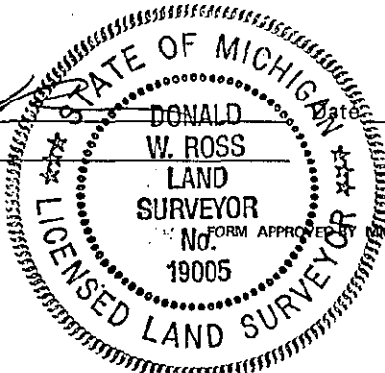

PA. 345 1990, APPROVED BY LIVINGSTON COUNTY  
PEER GROUP ON 10-9-96 CO. REP JEO

MICHIGAN STATE BOARD OF PROFESSIONAL SURVEYORS, JAN. 28, 197  
REVISED MAY 14, 197  
REVISED JAN., 198  
REVISED OCT. 199

DEERFIELD TOWNSHIP, T. 4 N., R. 5 E.

K-4, Corner common to Sections 11 and 12

Field, September 30, 1996, Donald W. Ross Associates

Found 3/8" iron rod in Green Road 6 feet West of the center line of the gravel surface. Witnesses cited in the various documents are consistent with the evidence found in the field.

1823 Hervey Parke, U.S. Deputy Surveyor - North on the line between Sections 11 and 12 of Deerfield Township set the 1/2 mile post common to Sections 11 & 12.

1967 A survey by an unknown surveyor indicates setting of a re-rod 36" long and shows witnesses.

1971 G. Fauser a surveyor for the Consumers Power Co. - Surveys the Majestic-Blackfoot Corridor (pages 14 & 15), and shows a found 3/8" iron rod and witnesses the same.

1978 R. Smith, surveys in the Northeast Quarter of Section 11 (page 18) and ties to the East Quarter corner of Section 11, and cites a found 1/2" re-rod, and witnesses the same.

1982 Ed Anderson, files an Act 74 (L.S.C. # 1309), and surveys in Section 11 and cites a found iron, and witnesses the same.

1983 G. Boss, surveys in the Southwest Quarter of Section 12 (page 21) and ties to the West Quarter corner of Section 12.

1987 G. Bonno, surveys in the Northeast Quarter of Section 11 (page 22 & 23) and ties to the West Quarter corner of Section 12, and cites a found 1/2" re-rod, and witnesses the same.

1990 H. Phillips, surveys in the Northeast Quarter of Section 11 (page 24) and ties to the East Quarter corner of Section 11, and cites a found 1/2" re-rod, and witnesses the same.

1995 G. Bono, surveys in the Northeast Quarter of Section 11 (page 25 & 26) and witnesses agree with the found iron rod.

I recommend replacing the found 3/8" iron rod with a breakaway remonumentation pipe and disk. The area is open overhead with woods East and West and is moderately suitable for GPS positioning.



Donald W. Ross RLS 19005  
October 9, 1996

