

FILED

LAND CORNER RECORDATION CERTIFICATE
Filing Requirement of Act 74, Mich. P.A. 1970

AUG 16 1 14 PM '94

NANCY HAVILAND
REGISTER OF DEEDS
LIVINGSTON COUNTY, MI
48843

For corners in

<u>Livingston</u> (County)	Located In:	Corner Code #
Public Land Survey	T <u>4</u> R <u>5</u>	<u>L-7</u>
	T _____ R _____	_____
	T _____ R _____	_____
	T _____ R _____	_____
Property Controlling in Section	S _____ T _____ R _____	_____
	S _____ T _____ R _____	_____
Miscellaneous Property in Sec.	S _____ T _____ R _____	_____
	S _____ T _____ R _____	_____

L.S.C.#216m

Register of Deeds Stamp & File Number

Lot No. _____, Recorded Plat _____
Private Claims _____

A	B	C	D	E	F	G	H	I	J	K	L	M
2	6	5	4	3	2	1						
3												
4	7	8	9	10	11	12						
5												
6	13	17	16	15	14	13						
7												
8	19	20	21	22	23	24						
9												
10	30	29	28	27	26	25						
11												
12	31	32	33	34	35	36						
13												

Edward E. Anderson in a field survey on August 2,
~~April 25,~~ 19 94

I hereby certify that under requirements of P.A. 74, Michigan P.A. of 1970, the corner points mentioned in lines 1 and 2 above were in conformance with regulations and rules therefore as required in the current manual of survey instructions of the United States Department of the Interior, Bureau of Land Management or by a decree of a Court of Law and/or that the corner points mentioned in lines 3, 4 and 5 above were in conformance with the rules of the Michigan Board of Land Surveyors or by a Decree of a Court of Law; established, re-established, monumented, re-monumented, recovered, found as expressed below:

NOTE: Not more than 4 corners, all in the same town and range, may be recorded on this certificate.

Description of original monument and accessories and/or subsequent restoration:

GLO DATED May 1, 1823
GLO WITNESSES W Oak 28" S68°E 37 Lks
W Oak 24" N5°W 37 Lks

Deputy Surveyor Henry Parker 1823-1825

ADDITIONAL HISTORICAL DATA ON BACK OF SHEET

SURVEY & REMONUMENTATION

SEP 26 1994

COMMISSION

Description of corner evidence found and/or method applied in restoring or reestablishing corner:

Found 1/2" rerod fit witnesses by Richard Smith P.S.


PA. 345 1990, APPROVED BY LIVINGSTON COUNTY,
PEER GROUP ON June 1, '94 CO. REP [Signature]

Description of monument for corner and accessories established to perpetuate locating the position of the corner:

L-7 N 1/4 CORNER SECTION 24, T4N-R5E
Set 1 1/4" x 36" Breakaway iron pipe with brass cap (Livingston County Monument corner) in centerline Center Road
S38°W 45.50' 1" x 36" iron pipe with Brass Cap (Livingston County Monument Witness)
N27°E 40.58' Spike S/S 8" Poplar
N70°W 86.35' Spike S/S 6" Walnut
S42°E 56.47' Spike W/S 10" Poplar

APPROVED BY LIVINGSTON COUNTY
MONUMENTATION PEER GROUP
JUNE 1, 1994

Signed by [Signature]
Surveyor's Michigan License No. 11495

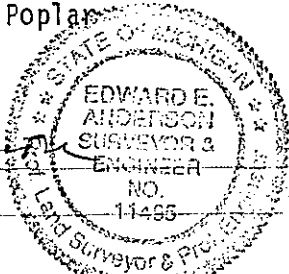

Date August 4, 1994



EDWARD E. ANDERSON, P.S., P.E.
RICHARD F. FRANK, P.S.
BRIAN R. SHALTZ, C.S.T.

Members of:
Michigan Society of Professional Surveyors
American Congress on Surveying and Mapping
American Society of Civil Engineers

401 S. Leroy St.
Fenton, Michigan 48430-2164

(313) 629-8974
FAX (313) 629-9069

May 11, 1994

SUMMARY

L-7 NORTH 1/4 CORNER SECTION 24, T4N-R5E, DEERFIELD TOWNSHIP,
LIVINGSTON COUNTY, MICHIGAN.

Found 1/2" rerod in centerline of Center Road (gravel)

Checked and measured to witnesses we found. Found all of Richard Smith
witnesses and they checked, Page 8 this dossier.

Distance from the N.W. Corner to the North 1/4 of said Section 24 is
2646.36' on Newton field notes, Page 7 this dossier.

Distance from N.E. corner to the North 1/4 corner of said Section 24 is
2655.02 on Newton field notes, Page 7, this dossier.


Made a clean sweep of immediate area and found no additional corners
or irons.

Found old fence line to North and South. Center Road (gravel) flat to
East and West. Terrain is open to NE, NW, and SW and wooded to the SE.

Came to the conclusion that the 1/2" rerod we found is the correct
North 1/4 corner of said Section 24.

Edward E. Anderson
P.S. #11495

NOTE: On 6/8/94, obtained additional information
regarding witnesses to said N 1/4 Corner.
Checked and measured to Newtons witnesses.
Found two of his witnesses and they checked.
The other witness was gone, Page 7, this
dossier. Checked and measured to Boss
Witnesses. Found three of his witnesses
and they checked. The other witness was
gone.

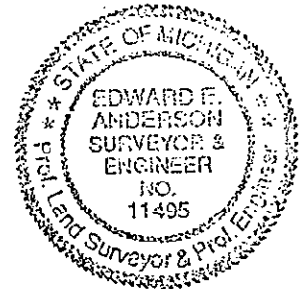

T4N R5E L-7 - PS4