

DEC 13 1993

COMMISSION

LAND CORNER RECORDATION CERTIFICATE  
 Filing Requirement of Act 74, Mich. P.A. 1970

For corners in

LIVINGSTON

(County)

Located In:

Corner Code ##

- |                                       |   |          |   |          |             |
|---------------------------------------|---|----------|---|----------|-------------|
| 1. Public Land Survey                 | T | <u>4</u> | R | <u>5</u> | <u>L-13</u> |
|                                       | T |          | R |          |             |
|                                       | T |          | R |          |             |
|                                       | T |          | R |          |             |
| 2. Property Controlling in Section    | S |          | T |          |             |
|                                       | S |          | T |          |             |
| 3. Miscellaneous Property in Sec.     | S |          | T |          |             |
|                                       | S |          | T |          |             |
| 4. Lot No. _____, Recorded Plat _____ |   |          |   |          |             |
| 5. Private Claims _____               |   |          |   |          |             |

NOV 9 9 45 AM '93  
 NANCY HAVILAND  
 REGISTER OF DEEDS  
 LIVINGSTON COUNTY, MI  
 48817

FILED

L.S.C. #33m  
 Register of Deeds Stamp & File Number

	A	B	C	D	E	F	G	H	I	J	K	L	M
2	6		5		4		3		2				
3													
4	7		8		9		10		11		12		
5													
6	18		17		16		15		14		13		
7													
8	19		20		21		22		23		24		
9													
10	30		29		28		27		26		25		
11													
12	31		32		33		34		35		36		
13													

I, Edward Anderson, in a field survey on August 20, 1993, do hereby certify that under requirements of P.A. 74, Michigan P.A. of 1970, the corner points mentioned in lines 1 and 2 above were in conformance with regulations and rules therefore as required in the current manual of survey instructions of the United States Department of the Interior, Bureau of Land Management or by a decree of a Court of Law and/or that the corner points mentioned in lines 3, 4 and 5 above were in conformance with the rules of the Michigan Board of Land Surveyors or by a Decree of a Court of Law; established, re-established, monumented, re-monumented, recovered, found as expressed below:

NOTE: Not more than 4 corners, all in the same town and range, may be recorded on this certificate.

A. Description of original monument and accessories and/or subsequent restoration:

GLO NOTES DATED MAY 1, 1823  
 GLO WITNESSES W. Oak 16" West 2 LKS  
 W. Oak 9" N78°E, 59 LKS

ADDITIONAL HISTORICAL DATA ON BACK OF SHEET

B. Description of corner evidence found and/or method applied in restoring or reestablishing corner:


FOUND 1/2" x 18" Iron. Fit Witnesses by Boss Engineering

C. Description of monument for corner and accessories established to perpetuate locating the position of the corner:

L-13 SOUTH 1/4 CORNER SECTION 36, T4N-R5E  
 Set 1 1/4" x 36 Breadaway Iron Pipe with Brass Cap (Livingston County Monument Corner) 6'± North of the South Edge Allen Road.  
 N40°W, 44.11' Spike E/S 15" Walnut  
 South 26.61' Spike W/S 36" Walnut  
 North 30.98' Spike E/S 10" Maple  
 N60°E 74.67' Spike S/S 22" Oak  
 East 123.23' to 1/2" Iron in Roadbed

APPROVED BY LIVINGSTON COUNTY  
 MONUMENTATION PEER GROUP  
 OCTOBER 10, 1993

Signed by E. Anderson  
 Surveyor's Michigan License No. 11495

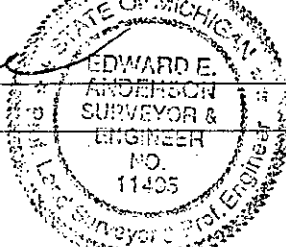

Date November 2, 1993



401 S. Leroy St.  
Fenton, Michigan 48430-2164

EDWARD E. ANDERSON, P.S., P.E.  
RICHARD F. FRANK, P.S.  
BRIAN R. SHALTZ, C.S.T.

Members of:  
Michigan Society of Professional Surveyors  
American Congress on Surveying and Mapping  
American Society of Civil Engineers

(313) 629-8974  
FAX (313) 629-9069

September 1, 1993

SUMMARY

L-13 SOUTH 1/4 CORNER SECTION 36, T4N-R5E, DEERFIELD TOWNSHIP  
LIVINGSTON COUNTY, MICHIGAN

Found 1/2" rerod. Had been disturbed but could tell where it went into the ground. Replaced with 1/2" rerod and checked the distance to the N 1/4 Corner of Section 1 (which I found using Boss Witnesses, Pages 6A, 6B; 7A and 7B), T3N-R5E, Oceola Township, and the measurement checked within 0.07 of the distance as computed using Boss and Benton Surveys Pages 6A and 9A of this dossier. Also, checked the distance to a witness by Benton (6" Beech N25°W, 27.92') Page 7B of this dossier. This was the only witness still existing, except for a 18" Oak N80°E, 75.57' by Benton and Garlock. This Oak was still in, but couldn't find the nail; however, the witness distance fell on the approximate centerline of the tree. This corner fell approximately 6' North of the South edge of the gravel road as per Garlock and Munsell (Act 74)


This corner was used for survey done by Benton 1977, and Act 74 by Munsell 1979, Page 9A and 14, this dossier. Distance from S 1/4 corner to the SW corner of said Section 36 is shown on Benton survey as 2629.04, Page 9A of this dossier, and I measured the distance from S 1/4 Corner to the SE Corner of said Section 36 as 2644.55.

Made a clean sweep of the immediate area and found no additional corners or irons.

Found no occupation running North and South; gravel road (Allen Road) running East and West. Ground slightly hilly, moderately wooded to the North and South.

Came to the conclusion that the 1/2" iron we replaced at the location of the disturbed iron was the correct S 1/4 Corner of said Section 36.

Edward E. Anderson  
P.S.#11495

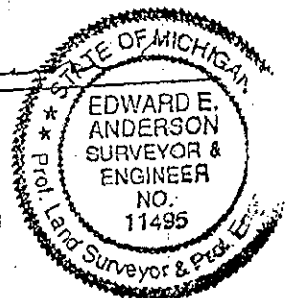

Architectural, Construction, Property and Drainage Surveys  
Civil Engineering • Land and Site Planning • Mortgage Inspection Reports

page 2