

LAND CORNER RECORDATION CERTIFICATE
Filing Requirement of Act 74, Mich. P.A. 1970

9-

For corners in

<u>Livingston</u> (County)	Located In:	Corner Code #
1. Public Land Survey	T <u>4</u> N R <u>5</u> E	<u>M-2</u>
	T _____ R _____	_____
	T _____ R _____	_____
	T _____ R _____	_____
2. Property Controlling in Section	S _____ T _____ R _____	_____
	S _____ T _____ R _____	_____
3. Miscellaneous Property in Sec.	S _____ T _____ R _____	_____
	S _____ T _____ R _____	_____
4. Lot No. _____, Recorded Plat _____		
5. Private Claims _____		

FILED

1996 DEC 30 A 11:14
 NANCY HAVILAND
 REGISTER OF DEEDS
 LIVINGSTON COUNTY, MI.
 48943

L.S.C.#651m
 Register of Deeds Stamp & File Number

1	A	B	C	D	E	F	G	H	I	J	K	L	M
2		6		5		4		3		2		1	
3													
4		7		8		9		10		11		12	
5													
6		18		17		16		15		14		13	
7													
8		19		20		21		22		23		24	
9													
10		30		29		28		27		26		25	
11													
12		31		32		33		34		35		36	
13													

I, Donald W. Ross, in a field survey on December 26, 1996 do hereby state that under requirements of P.A. 74, Michigan P.A. of 1970, the corner points mentioned in lines 1 and 2 above were in conformance with regulations and rules therefore as required in the current manual of survey instructions of the United States Department of the Interior, Bureau of Land Management or by a decree of a Court of Law and /or that the corner points mentioned in lines 3, 4 and 5 above were in conformance with the rules of the Michigan Board of Land Surveyors or by a Decree of a Court of Law; established, re-established, monumented, recovered, found as expressed below:

NOTE: Not more than 2 corners, all in the same town and range, may be recorded on this certificate.

A. Description of original monument and accessories and/or subsequent restoration:

M-2 The East Quarter corner of Section 1, Deerfield Township was set by the GLO in 1823 on a Re-Survey by Hervey Parke.

The original witnesses are:
 Y Oak 18" dia. Bears N 41 E 12 links (7.92')
 D O 10" dia. Bears S 44 E 32 links (21.12')

Note: None of the original witnesses could be found of perpetuated.
 See the back of this sheet for additional historical data.

B. Description of corner evidence found and/or method applied in restoring or reestablishing corner:


M-2 Fd. 1/2" re-rod established by Albright (1963), and witnessed by Ed Anderson (1985)

C. Description of monument for corner and accessories established to perpetuate locating the position of the corner:

M-2 East Quarter corner, Section 1, T4N, R6E
 Set 36" x 1 1/4" iron pipe and brass cap marked a "Livingston County Monument Corner".

N 40° E Set nail and tag in NW face of 10" Oak 25.86'
 N 61° E Set nail and tag in NW face of 12" Oak 13.09'
 S 85° E Set nail and tag in N face of 8" Oak 2.31'
 S 54° E Set nail and tag in SW face of 14" Oak 43.98'

Signed by Donald W. Ross Date December 26, 1996
 Surveyor's Michigan License No. 19005

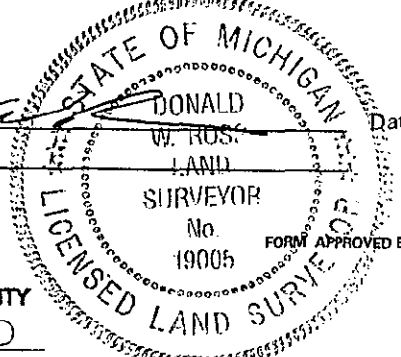

P.A. 345 1990, APPROVED BY LIVINGSTON COUNTY
 PFER GROUP ON 10-2-96 CO. REP JED

FORM APPROVED BY MICHIGAN STATE BOARD OF PROFESSIONAL SURVEYORS, JAN. 28, 197
 REVISED MAY 14, 197
 REVISED JAN., 198
 REVISED OCT. 199


DEERFIELD TOWNSHIP, T. 4 N., R. 5 E.

M-2, East Quarter Corner of Section 1

Field, September 25, 1996, Donald W. Ross Associates

Measured 1442 feet + or - Southerly from the center line of Bennett Lake Road and found a 1/2" capped iron "A-2" which was set or found by Delta Engineering No. 19002. I measured 146 feet + or - Southerly and found the 1/2" re-rod established (found) by Albright in 1963 and shown on a survey by Ed Anderson in 1985 (page 14). The witnesses on page 14 were evident, and we left the site.

I recommend setting a monumentation pipe and disk in place of the 1/2" iron witnessed by Albright. The area is not open and not suitable for GPS positioning.



Donald W. Ross RLS 19005
October 2, 1996

