

OCT 26 1995

COMMISSION

LAND CORNER RECORDATION CERTIFICATE

Filing Requirement of Act 74, Mich. P.A. 1970

FILED

SEP 15 12 02 PM '95

HANDY HAVILAND
REGISTER OF DEEDS
LIVINGSTON COUNTY, MI
48843

For corners in Livingston Located In: Corner Code #
(County)

- 1. Public Land Survey T 4 N R 6 E E-13
- T _____ R _____
- T _____ R _____
- T _____ R _____
- 2. Property Controlling S _____ T _____ R _____
- in Section S _____ T _____ R _____
- 3. Miscellaneous S _____ T _____ R _____
- Property in Section S _____ T _____ R _____

L. S. C. #427m

Register of Deeds Stamp & File Number

- 4. Lot No. _____, Recorded Plat _____
- 5. Private Claims _____

A	B	C	D	E	F	G	H	I	J	K	L	M
2	6		5		4		3		2		1	
3												
4	7		8		9		10		11		12	
5												
6	18		17		16		15		14		13	
7												
8	19		20		21		22		23		24	
9												
10	30		29		28		27		26		25	
11												
12	31		32		33		34		35		36	
13												

I, Edward E. Anderson in a field survey on July 26, 1995, do hereby certify that under requirements of P.A. 74, Michigan P.A. of 1970, the corner points mentioned in lines 1 and 2 above were in conformance with regulations and rules therefore as required in the current manual of survey instructions of the United States Department of the Interior, Bureau of Land Management or by a decree of a Court of Law and/or that the corner points mentioned in lines 3, 4 and 5 above were in conformance with the rules of the Michigan Board of Professional Surveyors or by a Decree of a Court of Law; established, re-established, monumented, re-monumented, recovered, found as expressed below:

NOTE: Not more than 4 corners, all in the same town and range, may be recorded on this certificate.

A. Description of original monument and accessories and/or subsequent restoration:

GLO NOTES DATED April 5, 1823
GLO WITNESSES W.Oak 20" S79°W 20 Lks
W. Oak 12" N67°E 52 Lks

ADDITIONAL HISTORICAL DATA ON BACK


B. Description of corner evidence found and/or method applied in restoring or reestablishing corner:

Found 3/4" iron. Fit witnesses by M.D.O.T., Albright, P.F.Thompson, Boss, and Flint Surveying

C. Description of monument for corner and accessories established to perpetuate locating the position of the corner:

E-13 SE COR SEC 32 T4N-R6E
Set 1 1/4" x 36" Breakaway iron pipe with brass cap (Liv. Co. Mon..Cor.)
in mon box in centerline Parshalville Road
S66°E 115.18' spike N/S power pole
S02°W 60.85' spike E/S 8" Elm
N76°W 208.83' Spike N/S 24" Elm
N02°W 139.82' Spike W/S 24" Hickory

Signed by [Signature]
Surveyor's Michigan License No. 11495

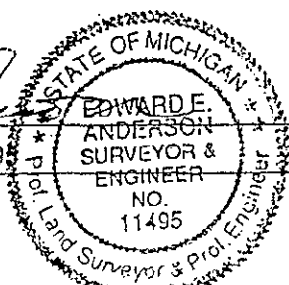

Date August 1, 1995

FORM APPROVED BY MICHIGAN STATE BOARD OF PROFESSIONAL SURVEYORS, JAN. 28, 1971
REVISED MAY 14, 1975
REVISED JAN., 1983



EDWARD E. ANDERSON, P.S., P.E.
RICHARD F. FRANK, P.S.
BRIAN R. SHALTZ, C.S.T.
Members of:
Michigan Society of Professional Surveyors
American Congress on Surveying and Mapping
American Society of Civil Engineers

401 S. Leroy St.
Fenton, Michigan 48430-2164

(313) 629-8974
FAX (313) 629-9069

SUMMARY

June 8, 1995

E-13 S.E. CORNER SECTION 32, T4N-R6E, TYRONE TOWNSHIP
LIVINGSTON COUNTY, MICHIGAN.

Found 3/4" iron in centerline of Parshalville Road (Black top)

Checked and measured to witnesses we found. Found 2 of 4 of Albright witnesses and they checked, pages 13 and 15 this dossier.

All of M.D.O.T. witnesses are gone, page 10 this dossier. Found all of Flint Surveying and Albright witnesses and they checked, pages 15 and 19²⁷ this dossier. Found all of Boss witnesses and they checked page 22 this dossier. We found the N.W. corner of Section 4, T3N-R6E, and measured to it. It measured 128.55' from the S.E. corner of said Section 32. G.L.O. is 128.7, page 24 this dossier.

B.F. Thompson &

Distance from the S.E. corner to the East 1/4 corner of said Section 32 is 2676.32' on Flint surveying, page 19 this dossier, and 2677.36' as measured in the field by E. Anderson on 6/6/95, pages 6 and 24 this dossier.

Distance from the S.E. corner to the South 1/4 corner of said Section 32 is 2640.51', being a combination of a distance on Boss survey and a measured distance by E. Anderson, pages 16, 17, 18, 20, 21, and 23 this dossier.
& 2640.53 on Thompson survey page 25 this Dossier

Made a clean sweep of immediate area and found no additional irons or corners.


Black top road east and west; rises to the west and falls to the east.

Terrain is open to the north and southeast, and wooded to the southwest.

Good location for G.P.S.

Came to the conclusion that the 3/4" iron we found is the correct S.E. corner of said Section 32.

E. Anderson
Edward E. Anderson
P.S.#11495

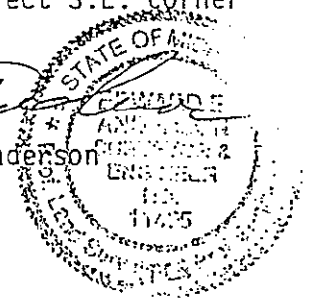

TYRONE E-13 PS4