

FILED

LAND CORNER RECORDATION CERTIFICATE
Filing Requirement of Act 74, Mich. P.A. 1970

AUG 16 1 15 PM '94

For corners in

Livingston Co (County)

Located In:

Corner Code #

NANCY HAVILAND
REGISTER OF DEEDS
LIVINGSTON COUNTY, MI
48843

- 1. Public Land Survey T 4 R 6 J-13
2. Property Controlling in Section S T R
3. Miscellaneous Property in Sec. S T R

L.S.C.#231m

Register of Deeds Stamp & File Number

- 4. Lot No. , Recorded Plat
5. Private Claims

Grid table with columns A-M and rows 2-13. A dot is marked in row 13, column J.

August 5,

I, Edward E. Anderson in a field survey on April 25, 1994 do hereby certify that under requirements of P.A. 74, Michigan P.A. of 1970, the corner points mentioned in lines 1 and 2 above were in conformance with regulations and rules therefore as required in the current manual of survey instructions of the United States Department of the Interior, Bureau of Land Management or by a decree of a Court of Law and/or that the corner points mentioned in lines 3, 4 and 5 above were in conformance with the rules of the Michigan Board of Land Surveyors or by a Decree of a Court of Law; established, re-established, monumented, re-monumented, recovered, found as expressed below:

NOTE: Not more than 4 corners, all in the same town and range, may be recorded on this certificate.

A. Description of original monument and accessories and/or subsequent restoration:

G.L.O. NOTES Dated April 5, 1823
G.L.O. WITNESSES W. Oak 12" N85°E 34 Lks
B. Oak 18" N16°E 39Lks

Deputy Surveyor Sylvester Sibley 1823-1825

ADDITIONAL HISTORICAL DATA ON BACK OF SHEET

SURVEY &
REMONUMENTATION

SEP 26 1994

COMMISSION

B. Description of corner evidence found and/or method applied in restoring or reestablishing corner:

Found 1/2" rerod fit witnesses by Delta Engineering, Richard Smith P.S., and Tri County Surveys, and Boss Engineering.


P.A. 345 1990, APPROVED BY LIVINGSTON CO. PEER GROUP ON June 1, 1994 CO. REP [Signature]

C. Description of monument for corner and accessories established to perpetuate locating the position of the corner:

J-13 S 1/4 COR SECTION 35 T4N-R6E
Set 1 1/4" x 36" Breakaway iron pipe with brass cap (Livingston County Monument Corner) 4'± South of centerline Holforth Road
N37°E 31.86' Spike S/S 10" Ash
S50°E 49.82' Spike N/S 16" Cherry
S6°W 24.08' Spike E/S 16" Cherry
N55°W 38.52' Spike S/S 6" Poplar
WEST 177.89' 1/2" Rerod

APPROVED BY LIVINGSTON COUNTY
MONUMENTATION PEER GROUP
JUNE 1, 1994

Signed by [Signature]

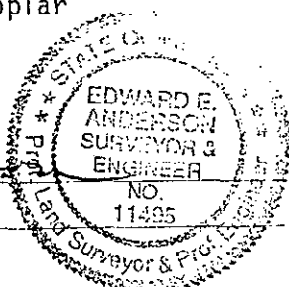

Date August 8, 1994

Surveyor's Michigan License No. 11495



EDWARD E. ANDERSON, P.S., P.E.
RICHARD F. FRANK, P.S.
BRIAN R. SHALTZ, C.S.T.

Members of:
Michigan Society of Professional Surveyors
American Congress on Surveying and Mapping
American Society of Civil Engineers

401 S. Leroy St.
Fenton, Michigan 48430-2164

(313) 629-8974
FAX (313) 629-9069

May 10, 1994

SUMMARY

J-13 SOUTH 1/4 CORNER SECTION 35, T4N-R6E, TYRONE TOWNSHIP, LIVINGSTON COUNTY, MICHIGAN.

Found capped 1/2" rerod (Richard Smith cap #23518) 4' South of centerline of Half-forth Road (gravel)

Checked and measured to witnesses we found. Found all of Delta and Richard Smith witnesses and they checked, Pages 13, 14, and 16, this dossier.

Found 3/8" rerod 177.89' West of the S 1/4 corner and it checked, Boss Survey and Tri-County Survey witnesses, Pages 7 and 10, this dossier. Boss and Tri-County called this iron the North 1/4 of Section 2, T3N-R6E, and also shown on Richard Smith field notes Pages 11 and 13, this dossier.

Distance from S.W. corner to the South 1/4 corner of said Section 35 is 2643.22' John Albright field notes Pages 11 and 12, this dossier.


Distance from S.E. corner to the South 1/4 corner of said Section 35 is 2664.85', John Albright field notes Pages 11 and 12, this dossier.

Made a clean sweep of immediate area and found no additional corners or irons.

Gravel Road East and West. Road rises to East and falls to West. No occupation to the North or South.

Terrain open North and South

Came to the conclusion that the 1/2" rerod we found is the correct South 1/4 corner of said Section 35.

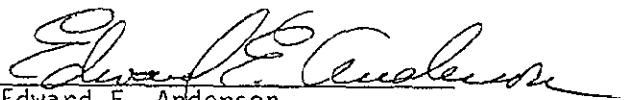
Edward E. Anderson
P.S.#11495



T4N R6E J-13 PS