

SURVEY & REMONUMENTATION

FEB 25 1999

SECTION

LAND CORNER RECORDATION CERTIFICATE
Filing Requirement of Act 74, Mich. P.A. 1970

9-
FILED

For corners in

<u>Livingston</u> <small>(County)</small>	Located In:	Corner Code //
1. Public Land Survey	T <u>4N</u> R <u>6E</u>	<u>K-2</u>
	T _____ R _____	_____
	T _____ R _____	_____
	T _____ R _____	_____
2. Property Controlling in Section	S _____ T _____ R _____	_____
	S _____ T _____ R _____	_____
3. Miscellaneous Property in Sec.	S _____ T _____ R _____	_____
	S _____ T _____ R _____	_____

1998 OCT 22 P 1:17

NANCY HAVILAND
REGISTER OF DEEDS
LIVINGSTON COUNTY, MI.
48843

1sc944M

Register of Deeds Stamp & File Number

4. Lot No. _____, Recorded Plat _____
5. Private Claims _____

	A	B	C	D	E	F	G	H	I	J	K	L	M
2	6	5	4	3	2	1							
3													
4	7	8	9	10	11	12							
5													
6	18	17	16	15	14	13							
7													
8	19	20	21	22	23	24							
9													
10	30	29	28	27	26	25							
11													
12	31	32	33	34	35	36							
13													

I, Bryan L. Boss, in a field survey on September 24, 1998, do hereby certify that under requirements of P.A. 74, Michigan P.A. of 1970, the corner points mentioned in lines 1 and 2 above were in conformance with regulations and rules therefore as required in the current manual of survey instructions of the United States Department of the Interior, Bureau of Land Management or by a decree of a Court of Law and/or that the corner points mentioned in lines 3, 4 and 5 above were in conformance with the rules of the Michigan Board of Land Surveyors or by a Decree of a Court of Law; established, re-established, monumented, re-monumented, recovered, found as expressed below:

NOTE: Not more than 4 corners, all in the same town and range, may be recorded on this certificate.

A. Description of original monument and accessories and/or subsequent restoration:

Yellow Oak 20" S 50 E 52
White Oak 9" S 81 W 36


B. Description of corner evidence found and/or method applied in restoring or reestablishing corner:

Found Railroad spike 0.5 West of Centerline Denton Hill Rd.

P.A. 345 1990, APPROVED BY LIVINGSTON COUNTY
PEER GROUP ON 8-5-98 CO. REP VED

C. Description of monument for corner and accessories established to perpetuate locating the position of the corner:
Set brass Cap inside 1 1/4 by 30" pipe with 6" break away.
Stamped "Livingston County monumentation Corner"

S 35 W 46.28 N/T South side p.pole
N 20 W 165.97 N/T p.pole
N 35 E 101.95 N/T North side p.pole
N 80 E 18.30 N/T South side guard rail
S 25 E 71.82 N/T West side 12" Oak

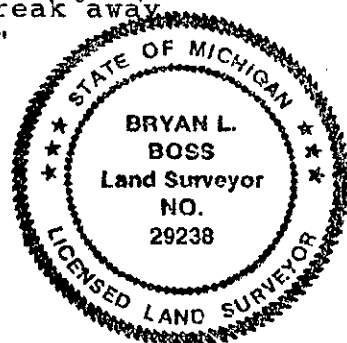

Signed by Bryan L. Boss

Date 10-14-98

Surveyor's Michigan License No. 29238