

FEB 25 1999

SECTION

LAND CORNER RECORDATION CERTIFICATE
Filing Requirement of Act 74, Mich. P.A. 1970

FILED

For corners in

1998 OCT 22 P 1:17

<u>Livingston</u> (County)	Located In:	Corner Code //
1. Public Land Survey	T <u>4N</u> R <u>6E</u>	<u>K-3</u>
	T _____ R _____	_____
	T _____ R _____	_____
	T _____ R _____	_____
2. Property Controlling in Section	S _____ T _____ R _____	_____
	S _____ T _____ R _____	_____
3. Miscellaneous Property in Sec.	S _____ T _____ R _____	_____
	S _____ T _____ R _____	_____

NANCY HAVILAND
REGISTER OF DEEDS
LIVINGSTON COUNTY, MI.
48843

LSC943M

Register of Deeds Stamp & File Number

4. Lot No. _____, Recorded Plat _____
5. Private Claims _____

A	B	C	D	E	F	G	H	I	J	K	L	M
2	6	5	4	3	2	1						
3												
4	7	8	9	10	11	12						
5												
6	16	17	16	15	14	13						
7												
8	19	20	21	22	23	24						
9												
10	30	29	28	27	26	25						
11												
12	31	32	33	34	35	36						
13												

I, Bryan L. Boss, in a field survey on September 24, 1998, do hereby certify that under requirements of P.A. 74, Michigan P.A. of 1970, the corner points mentioned in lines 1 and 2 above were in conformance with regulations and rules therefore as required in the current manual of survey instructions of the United States Department of the Interior, Bureau of Land Management or by a decree of a Court of Law and/or that the corner points mentioned in lines 3, 4 and 5 above were in conformance with the rules of the Michigan Board of Land Surveyors or by a Decree of a Court of Law; established, re-established, monumented, re-monumented, recovered, found as expressed below:

NOTE: Not more than 4 corners, all in the same town and range, may be recorded on this certificate.

A. Description of original monument and accessories and/or subsequent restoration:

White Oak 8" S 5 1/2 W 18
White Oak 18 N 28 W 33


B. Description of corner evidence found and/or method applied in restoring or reestablishing corner:

Found Railroad spike 2.50' East of centerline Fenton Rd.

P.A. 345 1960, APPROVED BY LIVINGSTON COUNTY
PEER GROUP ON 8-5-98 CO. REP JED

C. Description of monument for corner and accessories established to perpetuate locating the position of the corner:

Set monument box in Asphalt set 1 1/4' by 30" pipe with 6" breakaway 6" below top of monument box with brass cap stamped "Livingston County Monumentation Corner
S 80 W 77.97 N/T Northside power pole
N 30 W 100.62 N/T Eastside 14" Walnut
S 40 E 57.59 N/T Eastside power pole
N 39 E 93.61 N/T Westside 8" Elm

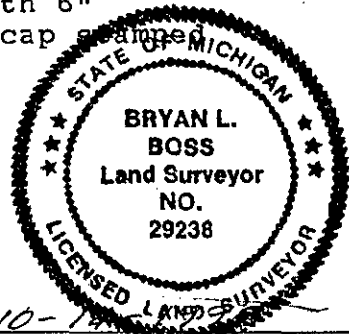

Signed by Bryan L. Boss Date 10-19-98
Surveyor's Michigan License No. 29238