

FEB 25 1999

SECTION

FILED

LAND CORNER RECORDATION CERTIFICATE

Filing Requirement of Act 74, Mich. P.A. 1970

1998 OCT 22 P 1:17

For corners in

Livingston  
(County)

Located In:

Corner Code //

NANCY HAVILAND  
REGISTER OF DEEDS  
LIVINGSTON COUNTY, MI.  
48843

- 1. Public Land Survey      T 4N R 6E      K-4  
                                   T \_\_\_\_\_ R \_\_\_\_\_  
                                   T \_\_\_\_\_ R \_\_\_\_\_  
                                   T \_\_\_\_\_ R \_\_\_\_\_
- 2. Property Controlling    S \_\_\_\_\_ T \_\_\_\_\_ R \_\_\_\_\_  
    in Section               S \_\_\_\_\_ T \_\_\_\_\_ R \_\_\_\_\_
- 3. Miscellaneous           S \_\_\_\_\_ T \_\_\_\_\_ R \_\_\_\_\_  
    Property in Sec.         S \_\_\_\_\_ T \_\_\_\_\_ R \_\_\_\_\_

LSC945M

Register of Deeds Stamp & File Number

- 4. Lot No. \_\_\_\_\_, Recorded Plat \_\_\_\_\_
- 5. Private Claims \_\_\_\_\_

A	B	C	D	E	F	G	H	I	J	K	L	M
2	6	5	4	3	2	1						
3												
4	7	8	9	10	11	12						
5												
6	18	17	16	15	14	13						
7												
8	19	20	21	22	23	24						
9												
10	30	29	28	27	26	25						
11												
12	31	32	33	34	35	36						
13												

I, Bryan L. Boss, in a field survey on September 24, 19 98, do hereby certify that under requirements of P.A. 74, Michigan P.A. of 1970, the corner points mentioned in lines 1 and 2 above were in conformance with regulations and rules therefore as required in the current manual of survey instructions of the United States Department of the Interior, Bureau of Land Management or by a decree of a Court of Law and/or that the corner points mentioned in lines 3, 4 and 5 above were in conformance with the rules of the Michigan Board of Land Surveyors or by a Decree of a Court of Law; established, re-established, monumented, re-monumented, recovered, found as expressed below:


NOTE: Not more than 4 corners, all in the same town and range, may be recorded on this certificate.

A. Description of original monument and accessories and/or subsequent restoration:  
 Black Oak 10" S 85 E 48  
 Black Oak 16" W 64 W 12

B. Description of corner evidence found and/or method applied in restoring or reestablishing corner:  
 Found pinch pipe 1' West of centerline Fenton Road

**P.A. 345 1980, APPROVED BY LIVINGSTON COUNTY**  
 PEER GROUP ON 8-5-98 CO. REP JED

C. Description of monument for corner and accessories established to perpetuate locating the position of the corner:  
 Set monument box in Asphalt, set 1 1/4' by 30" pipe w/6" break  
 away 6" below top of monument box with Brass cap Stamped  
 "Livingston County Monumentation Corner"  
 N 25 E 45.09 N/T Westside triple 20" Oak  
 S 80 E 33.71 N/T North side guy pole  
 West 58.61 N/T Northside power pole  
 S 50 W 38.34 N/T Southside 8" Elm

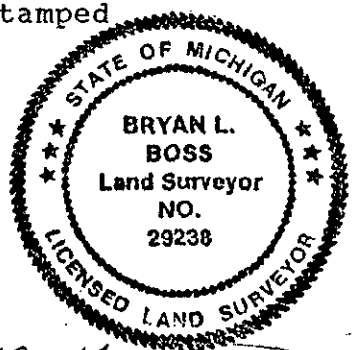

Signed by [Signature] Date 10-14-1998  
 Surveyor's Michigan License No. 29238