

FEB 25 1999

9-

FILED

SECTION

LAND CORNER RECORDATION CERTIFICATE
Filing Requirement of Act 74, Mich. P.A. 1970

1998 OCT 22 P 1:17

or corners in

Livingston
(County)

Located In:

Corner Code //

Public Land Survey

T 4N R 6E

K-6

T _____ R _____

T _____ R _____

T _____ R _____

Property Controlling
in Section

S _____ T _____ R _____

S _____ T _____ R _____

Miscellaneous
Property in Sec.

S _____ T _____ R _____

S _____ T _____ R _____

NANCY HAVILAND
REGISTER OF DEEDS
LIVINGSTON COUNTY, MI.
48843

LSC947M

Register of Deeds Stamp & File Number

Lot No. _____, Recorded Plat _____

Private Claims _____

	A	B	C	D	E	F	G	H	I	J	K	L	M
2	6	5	4	3	2	1							
3													
4	7	8	9	10	11	12							
5													
6	16	17	16	15	14	13							
7													
8	19	20	21	22	23	24							
9													
10	30	29	28	27	26	25							
11													
12	31	32	33	34	35	36							
13													

Bryan L. Boss, in a field survey on September 24, 1998,
to hereby certify that under requirements of P.A. 74, Michigan P.A. of 1970, the corner points mentioned
in lines 1 and 2 above were in conformance with regulations and rules therefore as required in the
current manual of survey instructions of the United States Department of the Interior, Bureau of Land
Management or by a decree of a Court of Law and/or that the corner points mentioned in lines 3, 4 and 5
above were in conformance with the rules of the Michigan Board of Land Surveyors or by a Decree of a
Court of Law; established, re-established, monumented, re-monumented, recovered, found as
expressed below:

NOTE: Not more than 4 corners, all in the same town and range, may be recorded
on this certificate.

1. Description of original monument and accessories and/or subsequent restoration:

Set post 1823
Yellow Oak 6" N 85 E 23 L
Black Oak 10" S 88 W 18 L

2. Description of corner evidence found and/or method applied in restoring or reestablishing corner:


Found spike in Mon. box

P.A. 345 1990, APPROVED BY LIVINGSTON COUNTY

PEER GROUP ON 8-5-98 CO. REP JED

3. Description of monument for corner and accessories established to perpetuate locating the position of the corner:

Set 1 1/4' by 30" iron pipe and 6" breakaway with Brass cap Stamped
"Livingston County Monumentation Corner" in existing monument
N 30 W 79.63 set Remon N/T Eastside 46" Oak
S 45 E 42.73 set Remon N/T Norhtside 24" Oak
N 75 E 103.44 set Remon N/T Southside 18" Cherry
S 40 W 85.42 set Remon N/T Northwest side power pole

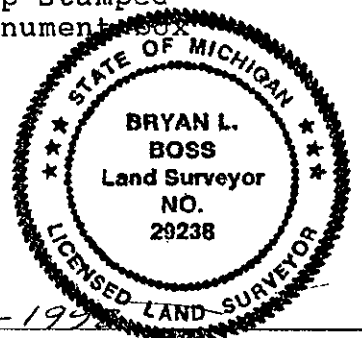

Signed by Bryan L. Boss

Date 10-15-1998

Surveyor's Michigan License No. 29238