

SURVEY & REMONUMENTATION

DEC 13 1993

LAND CORNER RECORDATION CERTIFICATE
 Filing Requirement of Act 74, Mich. P.A. 1970

COMMISSION

For corners in

LIVINGSTON

(County)

Located In:

Corner Code ##

- 1. Public Land Survey T 4 R 6 K-11
 T R
 T R
 T R
- 2. Property Controlling S T R
 in Section S T R
- 3. Miscellaneous S T R
 Property in Sec. S T R

- 4. Lot No. _____, Recorded Plat _____
- 5. Private Claims _____

FILED
 NOV 9 9 46 AM '93
 NANCY HAVILAND
 REGISTER OF DEEDS
 LIVINGSTON COUNTY, MI
 48843

L.S.C. #38m

Register of Deeds Stamp & File Number

	A	B	C	D	E	F	G	H	I	J	K	L	M
2	6		5		4		3		2		1		
3													
4	7		8		9		10		11		12		
5													
6	18		17		16		15		14		13		
7													
8	19		20		21		22		23		24		
9													
10	30		29		28		27		26		25		
11													
12	31		32		33		34		35		36		
13													

I, Edward Anderson, in a field survey on August 20, 1993, do hereby certify that under requirements of P.A. 74, Michigan P.A. of 1970, the corner points mentioned in lines 1 and 2 above were in conformance with regulations and rules therefore as required in the current manual of survey instructions of the United States Department of the Interior, Bureau of Land Management or by a decree of a Court of Law and/or that the corner points mentioned in lines 3, 4 and 5 above were in conformance with the rules of the Michigan Board of Land Surveyors or by a Decree of a Court of Law; established, re-established, monumented, re-monumented, recovered, found as expressed below:

NOTE: Not more than 4 corners, all in the same town and range, may be recorded on this certificate.

A. Description of original monument and accessories and/or subsequent restoration:

GLO NOTES DATED April 5, 1823
 GLO WITNESSES Poplar 10" N31°W, 232 LKS
 Tamarac 10" S32°E, 31 LKS

ADDITIONAL HISTORICAL DATA ON BACK OF SHEET

B. Description of corner evidence found and/or method applied in restoring or reestablishing corner:


Found 1/2" x 18" Iron 3' ± East of Centerline Black Top Road (Fenton Road)
 Fit Witnesses by Boss Engineering, Cornerstone Engineering, Garlock (Professional Surveyor), Richard Smith (Professional Surveyor)

C. Description of monument for corner and accessories established to perpetuate locating the position of the corner:

K-11 NW COR SEC 36, T4N-R6E
 Set 1 1/4" x 36" Breakaway Iron Pipe with Brass Cap (Livingston Co. Monument Corner) in Monument Box 3' East of Centerline Fenton Road.
 N40°W 63.98' Spike E/S 24" Twin Cherry
 S80°E 43.58' Spike W/S 18" W. Oak
 S40°E 58.88' Spike W/S 14" Twin Oak
 West 47.07' Spike S/S U. Pole

APPROVED BY LIVINGSTON COUNTY
 MONUMENTATION PEER GROUP
 OCTOBER 20, 1993

Signed by [Signature]
 Surveyor's Michigan License No. 11495

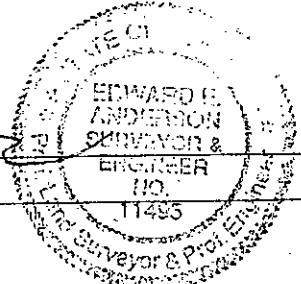

Date November 2, 1993



EDWARD E. ANL... P.S., P.E.
 RICHARD F. FRANK, P.S.
 BRIAN R. SHALTZ, C.S.T.
 Members of:
 Michigan Society of Professional Surveyors
 American Congress on Surveying and Mapping
 American Society of Civil Engineers

401 S. Leroy St.
 Fenton, Michigan 48430-2164

(313) 629-8974
 FAX (313) 629-9069

approved

September 24, 1993

SUMMARY

K-11 N.W. CORNER, SECTION 36, T4N-R6E, TYRONE TOWNSHIP,
 LIVINGSTON COUNTY, MICHIGAN.

Found 1/2" iron in Black top road (Fenton Road) 3' ± East of centerline.

R. Smith, Garlock and Boss used the same witnesses, Page 6, 9B, 14 and 15 this dossier. Found all their witnesses and they field checked to the iron that we found.

Cornerstone had different witnesses. Found their witnesses, Page 13A, and they field checked to the same iron that we found.

Distance from NW corner to N 1/4 corner of said Section 36 was 2683.42 per Feldhauser Survey and 2682.24 per Garlock, Page 16 this dossier. Distance from NW corner to W 1/4 corner of said Section 36 was 2669.25 per Smith, Pages 6, 11, and 12, this dossier.


Black top road (Fenton Road) running North and South. Found no old occupation to the West. Found an old fence line to the East.

Made a clean sweep of the immediate area and found no other irons or corners.

Terrain is fairly flat. Swampy ground to the east and west.

Came to the conclusion that the 1/2" iron we found was the correct N.W. corner of said Section 36.

E. Anderson
 Edward E. Anderson
 P.S. #11495

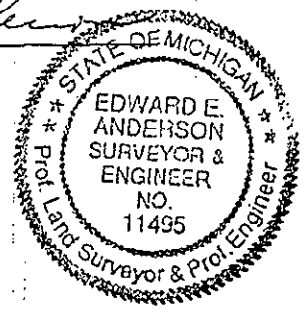

Architectural, Construction, Property and Drainage Surveys
 Civil Engineering • Land and Site Planning • Mortgage Inspection Reports