

SURVEY & REMONUMENTATION

DEC 13 1993

LAND CORNER RECORDATION CERTIFICATE Filing Requirement of Act 74, Mich. P.A. 1970

NOV 9 @ 46 AM '93
 NANCY HAYLAND
 REGISTER OF DEEDS
 LIVINGSTON COUNTY, MI
 48243

FILED

For corners in LIVINGSTON **COMMISSION**
(County)

Located In:		Corner Code #	
1. Public Land Survey	T <u>4</u> R <u>6</u>		<u>K-12</u>
	T _____ R _____		_____
	T _____ R _____		_____
	T _____ R _____		_____
2. Property Controlling in Section	S _____ T _____ R _____		_____
	S _____ T _____ R _____		_____
3. Miscellaneous Property in Sec.	S _____ T _____ R _____		_____
	S _____ T _____ R _____		_____

L.S.C. # 39m

Register of Deeds Stamp & File Number

4. Lot No. _____, Recorded Plat _____
 5. Private Claims _____

	A	B	C	D	E	F	G	H	I	J	K	L	M
2	6	5	4	3	2	1							
3													
4	7	8	9	10	11	12							
5													
6	18	17	16	15	14	13							
7													
8	19	20	21	22	23	24							
9													
10	30	29	28	27	26	25							
11													
12	31	32	33	34	35	36							
13													

I, Edward Anderson, in a field survey on August 20, 19 93, do hereby certify that under requirements of P.A. 74, Michigan P.A. of 1970, the corner points mentioned in lines 1 and 2 above were in conformance with regulations and rules therefore as required in the current manual of survey instructions of the United States Department of the Interior, Bureau of Land Management or by a decree of a Court of Law and/or that the corner points mentioned in lines 3, 4 and 5 above were in conformance with the rules of the Michigan Board of Land Surveyors or by a Decree of a Court of Law; established, re-established, monumented, re-monumented, recovered, found as expressed below:

NOTE: Not more than 4 corners, all in the same town and range, may be recorded on this certificate.

A. Description of original monument and accessories and/or subsequent restoration:

GLO DATE April 5, 1823
 GLO WITNESSES W. Oak 18" S73 1/2 W, 13 LKS
 W. Oak 14" N75° E, 50 LKS

ADDITIONAL HISTORICAL DATA ON BACK OF SHEET

B. Description of corner evidence found and/or method applied in restoring or reestablishing corner:


Found 1/2" x 18" Iron 3' ± East of Centerline of Black Top Road (Fenton Road)
 Fit witnesses by Boss Engineering, Garlock (Professional Surveyor), Cornerstone Engineering, Richard Smith (Professional Surveyor)

C. Description of monument for corner and accessories established to perpetuate locating the position of the corner:

K-12 W 1/4 CORNER SECTION 36, T4N-R6E
 Set 1 1/4" x 36" Breadaway Iron Pipe with Brass Cap (Livingston County Monument Corner)
 N45°W, 34.87' Spike N/S 24" Oak
 S80°E, 42.48' Spike N/S 20" Wild Cherry
 S30°E, 83.29' Spike W/S 30" Oak
 S40°W, 27.21' Spike E/S 26" Oak

APPROVED BY LIVINGSTON COUNTY
 MONUMENTATION PEER GROUP
 OCTOBER 20, 1993

Signed by Edward Anderson
 Surveyor's Michigan License No. 11495

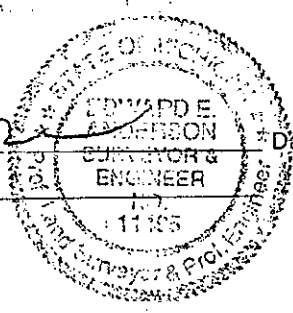

Date November 2, 1993



EDWARD E. ANDERSON, P.S., P.E.
 RICHARD F. FRANK, P.S.
 BRIAN R. SHALTZ, C.S.T.
 Members of:
 Michigan Society of Professional Surveyors
 American Congress on Surveying and Mapping
 American Society of Civil Engineers

401 S. Leroy St.
 Fenton, Michigan 48430-2164

(313) 629-8974
 FAX (313) 629-9069

approved

September 24, 1993

SUMMARY

K-12 W 1/4 CORNER, SECTION 36, T4N-R6E, TYRONE TOWNSHIP
 LIVINGSTON COUNTY, MICHIGAN

Found 1/2" iron in Black top road (Fenton Road), 3'± East of centerline.

Boss and Garlock used the same witnesses, Pages 8, 9, 11B, 15 and 17, this dossier. Found 3 witnesses; one was gone and they field checked to the iron we found.

R. Smith witnesses, Pages 6B, 12 and 16, this dossier. Found 3 witnesses; one was gone and they field checked to the iron we found.

Cornerstone witnesses, Page 14A this dossier. Found all their witnesses and they field checked to the iron we found.

Distance from W 1/4 to the NW corner of said Section 36 was 2669.25 per R. Smith Pages 6B, 12, and 13 this dossier. Distance from W 1/4 corner to the S.W. corner of said Section 36 was 2669.25 per R. Smith, Pages 6B, 12 and 13, this dossiers and 2669.43 per Boss, Pages 8 and 9 this dossier.

Black top road (Fenton Road) running North and South. Found no occupation to the West. Found no occupation to the East except centerline of gravel road (Sam Hill Road) falls 33'± north of the iron we found.

Made a clean sweep of the immediate area and found no other irons or corners.

Terrain is fairly flat. Open land to the East and West.

Came to the conclusion that the 1/2" iron we found was the correct West 1/4 Corner of said Section 36.

E. Anderson
 Edward E. Anderson
 P.S. #11495

Architectural, Construction, Property and Drainage Surveys
 Civil Engineering • Land and Site Planning • Mortgage Inspection Reports