

**SURVEY & REMONUMENTATION**

FEB 25 1999

9-

SECTION

FILED

**LAND CORNER RECORDATION CERTIFICATE**  
Filing Requirement of Act 74, Mich. P.A. 1970

For corners in

Livingston  
(County)

Located In:

Corner Code //

1998 OCT 22 P 1:18

NANCY HAVILAND  
REGISTER OF DEEDS  
LIVINGSTON COUNTY, MI.  
48843

949

LSC949M

Register of Deeds Stamp & File Number

- |                                       |                           |            |
|---------------------------------------|---------------------------|------------|
| 1. Public Land Survey                 | T <u>4N</u> - R <u>6E</u> | <u>L-3</u> |
|                                       | T _____ R _____           | _____      |
|                                       | T _____ R _____           | _____      |
|                                       | T _____ R _____           | _____      |
| 2. Property Controlling in Section    | S _____ T _____ R _____   | _____      |
|                                       | S _____ T _____ R _____   | _____      |
| 3. Miscellaneous Property in Sec.     | S _____ T _____ R _____   | _____      |
|                                       | S _____ T _____ R _____   | _____      |
| 4. Lot No. _____, Recorded Plat _____ |                           |            |
| 5. Private Claims _____               |                           |            |

	A	B	C	D	E	F	G	H	I	J	K	L	M
2	6	5	4	3	2	1							
3													
4	7	8	9	10	11	12							
5													
6	18	17	16	15	14	13							
7													
8	19	20	21	22	23	24							
9													
10	30	29	28	27	26	25							
11													
12	31	32	33	34	35	36							
13													

I, Bryan L. Boss, in a field survey on Oct. 12, 1998, do hereby certify that under requirements of P.A. 74, Michigan P.A. of 1970, the corner points mentioned in lines 1 and 2 above were in conformance with regulations and rules therefore as required in the current manual of survey instructions of the United States Department of the Interior, Bureau of Land Management or by a decree of a Court of Law and/or that the corner points mentioned in lines 3, 4 and 5 above were in conformance with the rules of the Michigan Board of Land Surveyors or by a Decree of a Court of Law; established, re-established, monumented, re-monumented, recovered, found as expressed below:

NOTE: Not more than 4 corners, all in the same town and range, may be recorded on this certificate.

A. Description of original monument and accessories and/or subsequent restoration:

Set post 1823  
White Oak 18" S 1 E 51 L  
White Oak 20" N 45 E 11 L

B. Description of corner evidence found and/or method applied in restoring or reestablishing corner:


Found 3" by 5' High steel post in concrete

PA. 345 1990, APPROVED BY LIVINGSTON COUNTY

PEER GROUP ON 9-16-98 CO. REP JED

C. Description of monument for corner and accessories established to perpetuate locating the position of the corner:  
Set Brass cap Stamped "Livingston County Monumentation Corner"  
cemented into top of 3" fence post

East 6.60' Remon N/T N/S 10" triple Hickory  
West 29.88 Remon N/T S/S 20" Hickory  
South 77.91 Remon N/T W/S 24" Oak  
N 40 E 113.55 Remon N/T NW/S 10" Maple

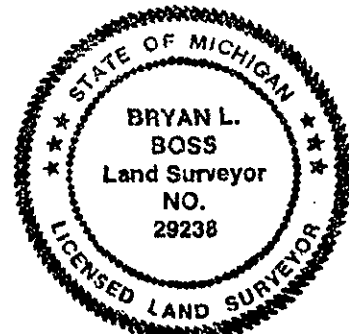

Signed by Bryan L. Boss  
Surveyor's Michigan License No. 29238

Date 10-15-1998