

**SURVEY & REMONUMENTATION**

FEB 25 1999

9-  
**FILED**

**SECTION**

**LAND CORNER RECORDATION CERTIFICATE**  
Filing Requirement of Act 74, Mich. P.A. 1970

1998 OCT 22 P 1:18

For corners in

Livingston  
(County)

Located In:

Corner Code //

- |                                    |                         |            |
|------------------------------------|-------------------------|------------|
| 1. Public Land Survey              | T <u>4N</u> R <u>6E</u> | <u>L-5</u> |
|                                    | T _____ R _____         | _____      |
|                                    | T _____ R _____         | _____      |
|                                    | T _____ R _____         | _____      |
| 2. Property Controlling in Section | S _____ T _____ R _____ | _____      |
|                                    | S _____ T _____ R _____ | _____      |
| 3. Miscellaneous Property in Sec.  | S _____ T _____ R _____ | _____      |
|                                    | S _____ T _____ R _____ | _____      |

NANCY HAVILAND  
REGISTER OF DEEDS  
LIVINGSTON COUNTY, MI.  
48843

LSC950M

Register of Deeds Stamp & File Number

4. Lot No. \_\_\_\_\_, Recorded Plat \_\_\_\_\_  
5. Private Claims \_\_\_\_\_

I, Bryan L. Boss, in a field survey on Oct. 12, 1998, do hereby certify that under requirements of P.A. 74, Michigan P.A. of 1970, the corner points mentioned in lines 1 and 2 above were in conformance with regulations and rules therefore as required in the current manual of survey instructions of the United States Department of the Interior, Bureau of Land Management or by a decree of a Court of Law and/or that the corner points mentioned in lines 3, 4 and 5 above were in conformance with the rules of the Michigan Board of Land Surveyors or by a Decree of a Court of Law; established, re-established, monumented, re-monumented, recovered, found as expressed below:

**NOTE:** Not more than 4 corners, all in the same town and range, may be recorded on this certificate.

	A	B	C	D	E	F	G	H	I	J	K	L
2	6	5	4	3	2	1						
3												
4	7	8	9	10	11	12						
5												
6	16	17	18	15	14	13						
7												
8	19	20	21	22	23	24						
9												
10	30	29	28	27	26	25						
11												
12	31	32	33	34	35	36						
13												

A. Description of original monument and accessories and/or subsequent restoration:

Set post 1823  
White Oak 8" S 27 E 28 L  
White 10" N 24 W 50 L

B. Description of corner evidence found and/or method applied in restoring or reestablishing corner:


Found capped iron rod # 14093

**P.A. 345 1990, APPROVED BY LIVINGSTON COUNTY**

PFR GROUP ON 9-16-98 CO. REP JED

C. Description of monument for corner and accessories established to perpetuate locating the position of the corner:

Set 36" by 1 1/4" pipe W/Brass cap Stamped Livingston County Monumentation Corner"  
S 80 E 40.94 Remon N/T S/S 12" Oak  
N 70 E 19.31 Remmon N/T S/S 8" Oak  
N 5 W 5.37' Remon N/T E/S 12" Oak  
S 20 W 38.09' Remon N/T E/S 18" Oak

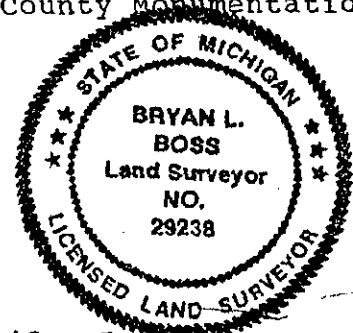

Signed by Bryan L. Boss

Date 10-15-98

Surveyor's Michigan License No. 29238