

**SURVEY & REMONUMENTATION**

FEB 25 1999

**FILED**

**SECTION**

**LAND CORNER RECORDATION CERTIFICATE**  
 Filing Requirement of Act 74, Mich. P.A. 1970

For corners in

Livingston  
County

Located In:

Corner Code //

1. Public Land Survey	T <u>4N</u> R <u>6E</u>	<u>L-7</u>
	T _____ R _____	_____
	T _____ R _____	_____
	T _____ R _____	_____
2. Property Controlling in Section	S _____ T _____ R _____	_____
	S _____ T _____ R _____	_____
3. Miscellaneous Property in Sec.	S _____ T _____ R _____	_____
	S _____ T _____ R _____	_____

1998 OCT 22 P 1:18

NANCY HAVILAND  
 REGISTER OF DEEDS  
 LIVINGSTON COUNTY, MI.  
 48843

LSC951M

Register of Deeds Stamp & File Number

4. Lot No. \_\_\_\_\_, Recorded Plat \_\_\_\_\_  
 5. Private Claims \_\_\_\_\_

	A	B	C	D	E	F	G	H	I	J	K	L	M
2	6	5	4	3	2								
3													
4	7	8	9	10	11	12							
5													
6	18	17	16	15	14	13							
7													
8	19	20	21	22	23	24							
9													
10	30	29	28	27	26	25							
11													
12	31	32	33	34	35	36							
13													

Bryan L. Boss, in a field survey on Oct. 12, 1998, to hereby certify that under requirements of P.A. 74, Michigan P.A. of 1970, the corner points mentioned in lines 1 and 2 above were in conformance with regulations and rules therefore as required in the current manual of survey instructions of the United States Department of the Interior, Bureau of Land Management or by a decree of a Court of Law and/or that the corner points mentioned in lines 3, 4 and 5 above were in conformance with the rules of the Michigan Board of Land Surveyors or by a Decree of a Court of Law; established, re-established, monumented, re-monumented, recovered, found as expressed below:

**NOTE: Not more than 4 corners, all in the same town and range, may be recorded on this certificate.**

1. Description of original monument and accessories and/or subsequent restoration:

Set post 1823  
 Yellow Oak 16" S 43½ E 27 L  
 White Oak 10" N 13 W 48 L


1. Description of corner evidence found and/or method applied in restoring or reestablishing corner:

Found 2" steel post in concrete

~~P.A. 343 1990, APPROVED BY LIVINGSTON COUNTY~~  
 PEER GROUP ON 9-2-98, CO. REP. JED

Description of monument for corner and accessories established to perpetuate locating the position of the corner:

Set Brass cap Stamped "Livingston County Monumentation Corner"  
 cemented on top of 2" steel post  
 N 40 W 16.61 Remon N/T S/S 26" Oak  
 West 21.42 Remon N/T N/S 30" Oak  
 S 5 W 16.17 Remon N/T E/S 10" tree  
 S 80 E 13.17 Remon N/T N/S 8" cherry  
 East 1.80' Fd. 1" Steel Bar

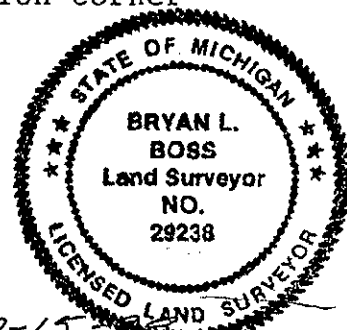

signed by Bryan L. Boss

Date 10-15-98

