

DEC 13 1993

COMMISSION

LAND CORNER RECORDATION CERTIFICATE
Filing Requirement of Act 74, Mich. P.A. 1970

NOV 9 9 46 AM '93
NANCY HAVILLAND
REGISTER OF DEEDS
LIVINGSTON COUNTY, MI
48843

FILED

For corners in LIVINGSTON (County)

Located In: Corner Code ##

1. Public Land Survey T 4 R 6 L-11

2. Property Controlling in Section S ___ T ___ R ___

3. Miscellaneous Property in Sec. S ___ T ___ R ___

L.S.C. #41m
Register of Deeds Stamp & File Number

4. Lot No. _____, Recorded Plat _____

5. Private Claims _____

	A	B	C	D	E	F	G	H	I	J	K	L	M
2	6		5		4		3		2		1		
3													
4	7		8		9		10		11		12		
5													
6	18		17		16		15		14		13		
7													
8	19		20		21		22		23		24		
9													
10	30		29		28		27		26		25		
11													
12	31		32		33		34		35		36		
13													

Edward E. Anderson in a field survey on August 20, 1993
 Do hereby certify that under requirements of P.A. 74, Michigan P.A. of 1970, the corner points mentioned in lines 1 and 2 above were in conformance with regulations and rules therefore as required in the current manual of survey instructions of the United States Department of the Interior, Bureau of Land Management or by a decree of a Court of Law and/or that the corner points mentioned in lines 3, 4 and 5 above were in conformance with the rules of the Michigan Board of Land Surveyors or by a Decree of a Court of Law, established, re-established, monumented, re-monumented, recovered, found as expressed below:

NOTE: Not more than 4 corners, all in the same town and range, may be recorded on this certificate.

Description of original monument and accessories and/or subsequent restoration:
 GLO NOTES DATED: April 5, 1823
 GLO WITNESSES: W. OAK 14" S25E, 48 LKS
 W. OAK 8" N27W, 60 LKS

ADDITIONAL HISTORICAL DATA ON BACK OF SHEET


Description of corner evidence found and/or method applied in restoring or reestablishing corner:
 This corner was set based on Physical and Written Evidence; Maps and Copies of Surveys by other Licensed Land Surveyors.

Description of monument for corner and accessories established to perpetuate locating the position of the corner:

L-11 NORTH 1/4 CORNER SECTION 36, T4N-R6E
 Set 1 1/4" x 36" Iron pipe with cap (Livingston Co. Monument Corner)
 N10E 41.52' Spike E/S 22' OAK
 N80E 48.11' Spike S/S 18" WILD CHERRY
 S50E 22.82' Spike N/S 42" OAK
 S05E 26.12' SPIKE W/S 24" OAK

APPROVED BY LIVINGSTON COUNTY
 MONUMENTATION PEER GROUP
 OCTOBER 27, 1993

Signed by E. Anderson
 Surveyor's Michigan License No. 11495

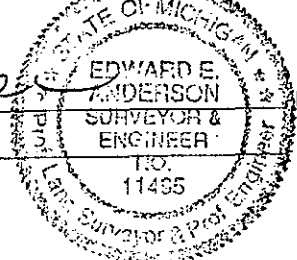

Date November 2, 1993



EDWARD E. ANDERSON, P.S., P.E.
RICHARD F. FRANK, P.S.
BRIAN R. SHALTZ, C.S.T.

Members of:
Michigan Society of Professional Surveyors
American Congress on Surveying and Mapping
American Society of Civil Engineers

401 S. Leroy St.
Fenton, Michigan 48430-2164

(313) 629-8974
FAX (313) 629-9069

approved

October 13, 1993

L-11 NORTH 1/4 CORNER SECTION 36, T4N-R6E, TYRONE TOWNSHIP,
LIVINGSTON COUNTY, MICHIGAN.

Found nothing at location of North 1/4 of said Section 36.

Witnesses of Anderson, Page 6B, this dossier, appeared to be incorrect when trying to locate in field and did not find any of them. No witnesses by others found in research.

Distance from the proposed N 1/4 Corner to the NW corner of said 36 is 2683.42' per Feldhauser Survey and Anderson. Distance from the proposed North 1/4 corner to the NE corner as set by Anderson of said Section 36 is 2659.68 and 2662.94 to the NE of said Section 36 as used by Kostecke. Distance from North 1/4 corner to the NE of said Section 36 2669.70' per Garlock, Page 7 and 8A, this dossier.


Old fence running North, East and West. No occupation to South.

Made clean sweep of area and found no irons.

Terrain fairly flat and wooded.

Came to the conclusion that correct location of the North 1/4 corner of said Section 36 should be at the location as shown on the sketch of field measurements, Page 8A, this dossier. This conclusion based on the available evidence found in our research and field measurements.

E. Anderson
Edward E. Anderson
P. S. #11495

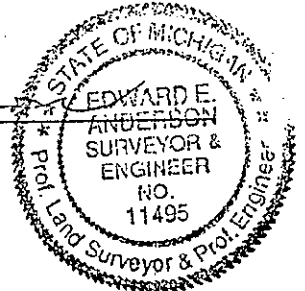

Architectural, Construction, Property and Drainage Surveys
Civil Engineering • Land and Site Planning • Mortgage Inspection Reports

Page 2