

FEB 24 1998

9- FILED

SECTION

LAND CORNER RECORDATION CERTIFICATE
Filing Requirement of Act 74, Mich. P.A. 1970

For corners in

<u>LIVINGSTON</u> (County)	Located In: TYRONE TWP.	Corner Code =# M-5
1. Public Land Survey	T <u>4N</u> R <u>6E</u>	_____
	T _____ R _____	_____
	T _____ R _____	_____
	T _____ R _____	_____
2. Property Controlling in Section	S _____ T _____ R _____	_____
	S _____ T _____ R _____	_____
3. Miscellaneous Property in Sec.	S _____ T _____ R _____	_____
	S _____ T _____ R _____	_____

1997 OCT -7 A 10: 56

NANCY HAVILAND
REGISTER OF DEEDS
LIVINGSTON COUNTY, MI.
48843

L.S.C. #712m

Register of Deeds Stamp & File Number

- 4. Lot No. _____, Recorded Plat _____
- 5. Private Claims _____

A	B	C	D	E	F	G	H	I	J	K	L	M
2	6	5	4	3	2	1						
3												
4	7	8	9	10	11	12						
5												
6	18	17	16	15	14	13						
7												
8	19	20	21	22	23	24						
9												
10	30	29	28	27	26	25						
11												
12	31	32	33	34	35	36						
13												

I, BRYAN L. BOSS, in a field survey on MAY 12, 1997, do hereby certify that under requirements of P.A. 74, Michigan P.A. of 1970, the corner points mentioned in lines 1 and 2 above were in conformance with regulations and rules therefore as required in the current manual of survey instructions of the United States Department of the Interior, Bureau of Land Management or by a decree of a Court of Law and/or that the corner points mentioned in lines 3, 4 and 5 above were in conformance with the rules of the Michigan Board of Land Surveyors or by a Decree of a Court of Law; established, re-established, monumented, re-monumented, recovered, found as expressed below:

NOTE: Not more than 4 corners, all in the same town and range, may be recorded on this certificate.

A. Description of original monument and accessories and/or subsequent restoration:


WHITE OAK 5" N 17 E 18 LINKS
WHITE OAK 7" S 62 W 26 LINKS

B. Description of corner evidence found and/or method applied in restoring or reestablishing corner:

1/2" INCH X 6" INCH IRON FOUND OVER POINTED STONE. REMOVED BOTH AND SET 1 1/4" X 30" PIPE ONE FOOT BELOW GRAVEL SURFACE. SET 6" INCH BREAKAWAY AND BRASS CAP STAMPED "LIVINGSTON COUNTY MONUMENTATION CORNER IN 30" PIPE. OCCUPATION TREE AND FENCE LINE WESTERLY.

C. Description of monument for corner and accessories established to perpetuate locating the position of the corner:

SEE "B" ABOVE.
N 30 E 36.67' NAIL & TAG WEST SIDE 8" TRIPLE HICKORY
N 85 E 17.59' NAIL & TAG SOUTH SIDE 30" OAK
S 40 W 35.08' NAIL & TAG EAST SIDE 14" HICKORY
N 75 W 27.29' NAIL & TAG SOUTH SIDE 30" OAK
SOUTH 125.57' NORTHWEST CORNER, SECTION 18 ROSE TOWNSHIP

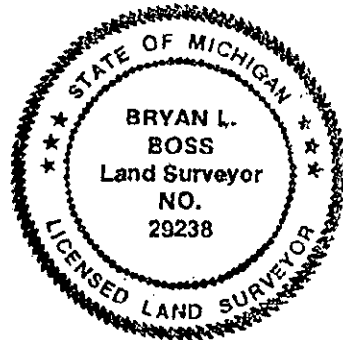

Signed by [Signature] Date Sept. 22, 1997
Surveyor's Michigan License No. 29238

SUMMARY
M-5

Northeast Corner, Section 13, Tyrone Township, Livingston County, Michigan.

Corner set by Alex Holmes in 1815. The G.L.O. Map logs 116.16 feet at Township jog.

In 1971, Consumers Power Surveyor C.W. Dorsey set "T" Iron Government jog distance from Southwest Corner, Section 7, Rose Township (see page 13 this dossier) Note the "T" iron is 10 ft. South of fence to West, this point was not relocated.

WITNESSES

A-5 Rose Twp. Subsequent surveys by Marvin Pike, Calvin Nabers, and John Albright witness Southwest Corner of Section 7, Rose Township, and match Dorsey witnesses, however these surveys do not reference Northeast Corner of Section 13, Tyrone Township.


M-5 Tyrone Twp. On September 6, 1980, Richard L. Smith RLS #23518 found painted stone per Maurice Baldwin's field notes and set a 1/2 inch bar with cap. See witness sheet on page 7, this dossier. Richard L. Smith recorded South 125.57 feet to Northwest Corner, Section 13, Rose Township. On September 10, 1991, Richard F. Frank found 1/2' Iron Rod with Cap R.L.S 23518 and measured South 125.57 feet to the Northwest Corner, Section 13, Rose Township.

On March 24, 1997, Boss Engineering found 1/2" rered at occupation tree and fence row Westerly. The iron was 1/2 foot deep in centerline of Tipsico Lake Road and cap was damaged. Witnesses match Smith and the point measures 125.57 feet from A-5 Rose Twp.

This corner is in the centerline of Tipsico Lake Road and open for G.P.S.

We recommend accepting iron set by Richard L. Smith to be the Northeast corner of Section 13, Tyrone Township.

File: Summ-5

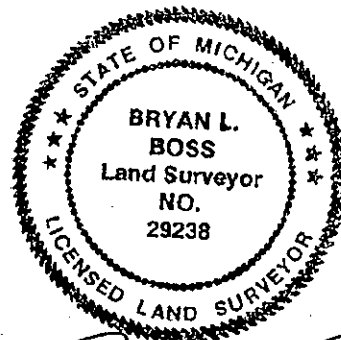

Bryan L. Boss