

DEC 13 1993

COMMISSION

LAND CORNER RECORDATION CERTIFICATE
Filing Requirement of Act 74, Mich. P.A. 1970

Nov 9 9 46 AM '93
RANCY HAVILAND
REGISTER OF DEEDS
LIVINGSTON COUNTY, MI
48843

FILED

For corners in
LIVINGSTON
(County)

Located In: Corner Code #

- 1. Public Land Survey T 4 R 6 M-11
- T _____ R _____
- T _____ R _____
- T _____ R _____
- T _____ R _____
- 2. Property Controlling S _____ T _____ R _____
- in Section S _____ T _____ R _____
- 3. Miscellaneous S _____ T _____ R _____
- Property in Sec. S _____ T _____ R _____

L.S.C. #43m

Register of Deeds Stamp & File Number

- 4. Lot No. _____, Recorded Plat _____
- 5. Private Claims _____

	A	B	C	D	E	F	G	H	I	J	K	L	M
2	6		5		4		3		2		1		
3													
4	7		8		9		10		11		12		
5													
6	16		17		18		15		14		13		
7													
8	19		20		21		22		23		24		
9													
10	30		29		28		27		26		25		
11													
12	31		32		33		34		35		36		
13													

I, E. Anderson, in a field survey on August 20, 1993, 19____, do hereby certify that under requirements of P.A. 74, Michigan P.A. of 1970, the corner points mentioned in lines 1 and 2 above were in conformance with regulations and rules therefore as required in the current manual of survey instructions of the United States Department of the Interior, Bureau of Land Management or by a decree of a Court of Law and/or that the corner points mentioned in lines 3, 4 and 5 above were in conformance with the rules of the Michigan Board of Land Surveyors or by a Decree of a Court of Law; established, re-established, monumented, re-monumented, recovered, found as expressed below:

NOTE: Not more than 4 corners, all in the same town and range, may be recorded on this certificate.

A. Description of original monument and accessories and/or subsequent restoration:

GLO DATE: April 5, 1823
GLO WITNESSES B: OAK 17" N88°E, 29 LKS
B: OAK 17" S50°E, 29 LKS

ADDITIONAL HISTORICAL DATA ON BACK OF SHEET

B. Description of corner evidence found and/or method applied in restoring or reestablishing corner:


Found 1/2" x 18" Iron. This Iron fit witnesses by E. E. Anderson & Assoc., and Alpha Engineering.

NOTE: ACT 74 recorded in L.S.C. 1426, dated 11-7-89, was labeled M-11 of T4N-R6E, was actually witnessing corner A-11 of T4N-R7E.

C. Description of monument for corner and accessories established to perpetuate locating the position of the corner:

M-11 NE COR SEC 36, T4N-R6E
Set 1 1/4" x 36" Breakaway Iron pipe with Brass cap (Livingston County Monument Corner) 7' West of centerline of Tipsico Lake Road
N35°E, 67.70' Spike S/S 24" Wild Cherry
S35°E 63.85' Spike E/S 16" Cherry
S40°W, 36.81' Spike N/S 24" Twin Cherry
N30°W, 44.17' Spike E/S 48" Oak
East 3.26' 1/2" Iron in Road bed
South 94.07' 1" Solid Iron Pipe in Roadbed

Signed by _____
Surveyor's Michigan Licence No. 11495

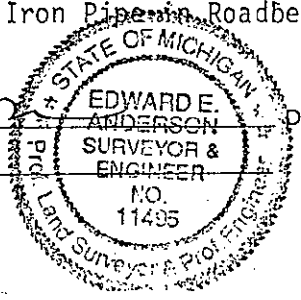

APPROVED BY LIVINGSTON COUNTY
MONUMENTATION PEER GROUP
OCTOBER 27, 1993
Date November 2, 1993



EDWARD E. ANDERSON, P.S., P.E.
RICHARD F. FRANK, P.S.
BRIAN R. SHALTZ, C.S.T.
Members of:
Michigan Society of Professional Surveyors
American Congress on Surveying and Mapping
American Society of Civil Engineers

401 S. Leroy St.
Fenton, Michigan 48430-2164

(313) 629-8974
FAX (313) 629-9069

approved

October 13, 1993

M-11 NE CORNER SECTION 36, T4N-R6E, TYRONE TOWNSHIP,
LIVINGSTON COUNTY, MICHIGAN.

Found 1/2" iron set by Anderson in 1977 survey, Page 6A, 6B, this dossier. Also found 1/2" iron 3.26' East of iron set by Anderson. Irons fall in approximate centerline of gravel Road (Tipsico Lake Road).

Found Anderson witnesses and checked to the iron set by Anderson, Page 6B this dossier. Found Alpha witnesses and checked to the iron set by Anderson, Page 9 this dossier. Found Delta witnesses (Page 13 this dossier) to the NE corner of said Section 36 and they fit an iron that is at the NW corner of Section 31, T4N-R7E, according to the recorded plat of Roseman Shores this dossier.

Distance from the NE corner as set by Anderson to the proposed North 1/4 corner of said Section 36 is 2659.68 and 2662.94 to the iron at the NE corner of said 36 that is 3.26' east of Anderson iron. Distance from the NE corner to the East 1/4 corner of said Section 36 is 2698.98' per Alpha, Page 8 this dossier.


Gravel Road running North and South (Tipsico Lake Road). No occupation to the East. Old fence line to the West.

Made a clean sweep of immediate area and found no additional irons or corners.

Terrain fairly flat and wooded.

Came to the conclusion that the 1/2" iron used by Anderson in 1977, Page 6A and 6B this dossier is the correct location of the NE corner of said Section 36. This conclusion is based on field measurements made by Anderson as shown on sketch of field measurements, Pages 14A and 14B, this dossier.

E. Anderson
Edward E. Anderson
P.S.#11495

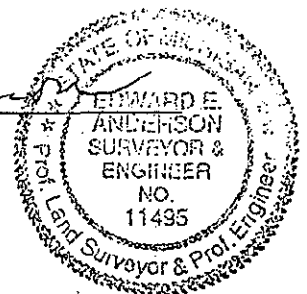

Architectural, Construction, Property and Drainage Surveys
Civil Engineering • Land and Site Planning • Mortgage Inspection Reports

Page 2