

MAR 13 1998

SECTION

MACKINAC COUNTY REMONUMENTATION CORNER

LAND CORNER RECORDATION CERTIFICATE

Filing Requirement of Act 74, Mich. P.A. 1970

For corners in


Mackinac (County) Located In: Corner Code ##

| | | |
|------------------------------------|--------------------------|---------------------------|
| 1. Public Land Survey | T <u>40N</u> R <u>3W</u> | <u>B-3</u> |
| | T ___ R ___ | <u>1/4 Cor common</u> |
| | T ___ R ___ | <u>to Sec's 6 & 7</u> |
| | T ___ R ___ | _____ |
| 2. Property Controlling in Section | S ___ T ___ R ___ | _____ |
| | S ___ T ___ R ___ | _____ |
| 3. Miscellaneous Property in Sec. | S ___ T ___ R ___ | _____ |
| | S ___ T ___ R ___ | _____ |

RECEIVED & FILED
 DIANE FRANKOVICH
 MACKINAC COUNTY REGISTER OF DEEDS
 DEC 29 1997
 AM PM
 7/8/9/10/11/12/13/14/15/16

Register of Deeds Stamp & File Number

- 4. Lot No. _____, Recorded Plat _____
- 5. Private Claims _____

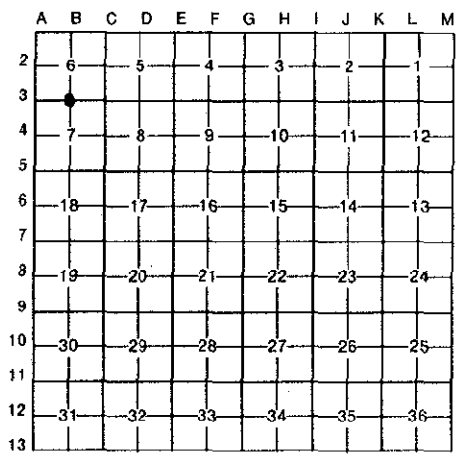

I, Neil E. Hill, in a field survey on DECEMBER 22, 1997, do hereby certify that under requirements of P.A. 74, Michigan P.A. of 1970, the corner points mentioned in lines 1 and 2 above were in conformance with regulations and rules therefore as required in the current manual of survey instructions of the United States Department of the Interior, Bureau of Land Management or by a decree of a Court of Law and/or that the corner points mentioned in lines 3, 4 and 5 above were in conformance with the rules of the Michigan Board of Land Surveyors or by a Decree of a Court of Law; established, re-established, monumented, re-monumented, recovered, found as expressed below:

NOTE: Not more than 4 corners, all in the same town and range, may be recorded on this certificate.

A. Description of original monument and accessories and/or subsequent restoration:
 1845 GLO notes Austin Burt 15" W. Pine N53E 2.18 ch
 No records of corner being perpetuated, however various surveys have noted this corner
 1975 C.A. & E. Survey (unrecorded)

B. Description of corner evidence found and/or method applied in restoring or reestablishing corner:
 1997 Found 3/4" pipe with steel fence iron in monument box. Accepted corner location.
 Old witnesses from Charlevoix survey.
 P.P. N70E 107.35 (Pole gone)
 P.P. N45W 66.4 (Face)
 NE cor house S45W 96.2 (gone)

ACCEPTED BY THE MACKINAC COUNTY SURVEY PEER GROUP AS THE OFFICIAL CORNER UNDER P.A. 345 OF 1990 AT A MEETING HELD ON 12-12-97

C. Description of monument for corner and accessories established to perpetuate locating the position of the corner:
 Found 3/4" pipe with steel fence iron in monument box. Set 1/2" rod with cap inside 3/4" pipe.
 Power Pole N70E 110.66' Tag 16041 Power Pole N45W 66.82' MDOT tag
 Plat Monu. Due North 32.80' Wood Gate Post S20W 33.76'

STATE OF MICHIGAN
 NEIL E. HILL
 Land Surveyor
 No. 27447
 DECEMBER 22, 1997

Signed by Neil E. Hill P.S. Date _____
 Surveyor's Michigan License No. 27447