2 SURVEY & REMONUMENTATION

MAR 13 1998

SECTION

MACKINAC COUNTY REMONUMENTATION CORNER

LAND CORNER RECORDATION CERTIFICATE

Filing Requirement of Act 74, Mich. P.A. 1970

For corners in

Mackinac (County)

	Located In:	Corner Code #
1. Public Land Survey	T 40N R 4W	G-4
	T ___ R ___	¼ Cor common
	T ___ R ___	~~to Sec's 9 & 10~~
	T ___ R ___	
2. Property Controlling	S ___ T ___ R ___	
in Section	S ___ T ___ R ___	
3. Miscellaneous	S ___ T ___ R ___	
Property in Sec.	S ___ T ___ R ___	

RECEIVED & FILED
DIANE FRIAR KOVICH
MACKINAC COUNTY REGISTER OF DEEDS
DEC 29 1997
AM PM
7 8 9 10 11 12 1 2 3 4 5 6

Register of Deeds Stamp & File Number

4. Lot No. _____ , Recorded Plat _____
5. Private Claims _____

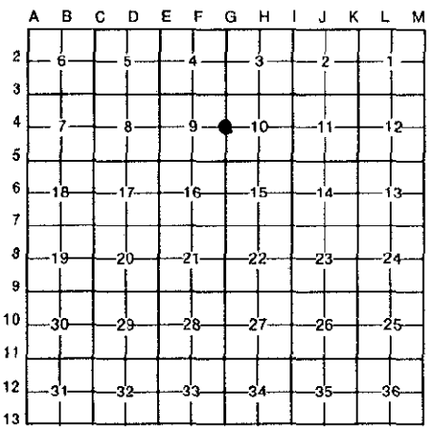

I, Neil E. Hill, *in a field survey on* DECEMBER 22 97, *19* _____, do hereby certify that under requirements of P.A. 74, Michigan P.A. of 1970, the corner points mentioned in lines 1 and 2 above were in conformance with regulations and rules therefore as required in the current manual of survey instructions of the United States Department of the Interior, Bureau of Land Management or by a decree of a Court of Law and/or that the corner points mentioned in lines 3, 4 and 5 above were in conformance with the rules of the Michigan Board of Land Surveyors or by a Decree of a Court of Law; established, re-established, monumented, re-monumented, recovered, found as expressed below:

***NOTE:* Not more than 4 corners, all in the same town and range, may be recorded on this certificate.**

A. Description of original monument and accessories and/or subsequent restoration:

1845	GLO notes	William Burt	12" Cedar	N37W	8 lks
			10" Fir	S49E	30 lks

1977 Max Connell, MDOT
Found fence South & West; found 1½" pipe with 3" squared cedar post
Recorded Liber B, page 64

B. *Description of corner evidence found and/or method applied in restoring or reestablishing corner:*

1997 Found 1¼" steel pipe (Old witnesses)

9" Cedar	S30W	12.00'
7" Cedar	S40E	25.86'
10" Birch	N80E	6.28'

ACCEPTED BY THE MACKINAC COUNTY SURVEY PEER GROUP AS THE OFFICIAL CORNER UNDER P.A. 345 OF 1990 AT A MEETING HELD ON 12-12-97

C. Description of monument for corner and accessories established to perpetuate locating the position of the corner:

Set ½" rerod with remonumentation cap inside pipe.

8"	Cedar	N35W	11.54 (Tag 41099)
10"	Birch	N80E	06.32 (MDOT)
6"	Maple	S60E	18.71 (Tag 41099)
12"	Cedar	S45W	12.06 (Tag 41099)

STATE OF MICHIGAN
NEIL E. HILL
Land Surveyor
No. 27447
REGISTERED LAND SURVEYOR

Signed by Neil E. Hill P.S. Date DECEMBER 22, 1997

Surveyor's Michigan License No. 27447

FORM APPROVED BY MICHIGAN STATE BOARD OF LAND SURVEYORS, JAN. 28, 1971
REVISED MAY 14, 1975
REVISED JAN., 1983

E- 161