

MAY 20 1997

COMM

MACKINAC COUNTY REMONUMENTATION CORNER
LAND CORNER RECORDATION CERTIFICATE
Filing Requirement of Act 74, Mich. P.A. 1970

For corners in

<u>Mackinac</u> (County)	Located In:	Corner Code #
1. Public Land Survey	T <u>40N</u> R <u>4W</u>	<u>J-1</u>
	T _____ R _____	_____
	T _____ R _____	<u>1/4 cor common to</u>
	T _____ R _____	<u>Sec.'s 2-35</u>
2. Property Controlling in Section	S _____ T _____ R _____	_____
	S _____ T _____ R _____	_____
3. Miscellaneous Property in Sec.	S _____ T _____ R _____	_____
	S _____ T _____ R _____	_____
4. Lot No. _____, Recorded Plat _____		
5. Private Claims _____		

RECEIVED & FILED
DIANE FRANKOVICH
MACKINAC COUNTY REGISTER OF DEEDS

NOV 7 5 1996
AM _____ PM _____
7|8|9|10|11|12|1|2|3|4|5|6

Register of Deeds Stamp & File Number

2652.44' U.S. F.S.

A	B	C	D	E	F	G	H	I	J	K	L	M
2	6	5	4	3	2	1						
3												
4	7	8	9	10	11	12						
5												
6	13	17	16	15	14	13						
7												
8	19	20	21	22	23	24						
9												
10	30	29	28	27	26	25						
11												
12	31	32	33	34	35	36						
13												

I, Neil E. Hill, in a field survey on SEPTEMBER 30, 19 96, do hereby certify that under requirements of P.A. 74, Michigan P.A. of 1970, the corner points mentioned in lines 1 and 2 above were in conformance with regulations and rules therefore as required in the current manual of survey instructions of the United States Department of the Interior, Bureau of Land Management or by a decree of a Court of Law and/or that the corner points mentioned in lines 3, 4 and 5 above were in conformance with the rules of the Michigan Board of Land Surveyors or by a Decree of a Court of Law; established, re-established, monumented, re-monumented, recovered, found as expressed below:

NOTE: Not more than 4 corners, all in the same town and range, may be recorded on this certificate.

A. Description of original monument and accessories and/or subsequent restoration:

Corner re-established and set at proportionate distance between recovered and re-established corners to the east and west on the township line.

G.L.O. notes. Set 1/4 corner post.
7" Birch N39E 11 lks
7" Birch N45W 4 lks

Recorded Liber B, Page 328.

B. Description of corner evidence found and/or method applied in restoring or reestablishing corner:

Found F.F.S. std. monument
2 1/2" x 5' concrete filled galvanized iron pipe 3.1' in ground with 3" brass tablet. (Found 3.4' out of ground)
5" Cedar S88E 2.1'
7" Cedar N14W 17.4'
6" Cedar N60W 7.5'

Cedar post, North 3.25' with monument sign attached.
Accepted corner location


ACCEPTED BY THE MACKINAC COUNTY
SURVEY PEER GROUP AS THE
OFFICIAL CORNER UNDER P.A.
345 OF 1990 AT A MEETING
HELD ON 9-30-96

James H. Drayton

Also recorded in: T 41N, R4W, J-13

C. Description of monument for corner and accessories established to perpetuate locating the position of the corner:

Accepted corner as found. Measurements to nails in side of trees.
7" Cedar S88E 2.62'
9" Cedar N14W 17.29'
8" Cedar N60W 7.18'
6" Cedar S20W 14.54'

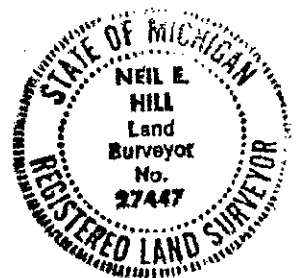

Signed by Neil E. Hill P.S., P.C. Date SEPTEMBER 30, 1996
Surveyor's Michigan License No. 27447