SURVEY & REMONUMENTATION

MAR 13 1998

SECTION

MACKINAC COUNTY REMONUMENTATION CORNER

LAND CORNER RECORDATION CERTIFICATE

Filing Requirement of Act 74, Mich. P.A. 1970

For corners in

Mackinac (County)

	Located In:	Corner Code #
1. Public Land Survey	T 40N R 4W	M-4
	T ___ R ___	~~E ¼ Sec 12~~
	T 40N R ~~3W~~	~~A-4~~
	T ___ R ___	~~W¼ Sec 7~~
2. Property Controlling	S ___ T ___ R ___	
in Section	S ___ T ___ R ___	
3. Miscellaneous	S ___ T ___ R ___	
Property in Sec.	S ___ T ___ R ___	

RECEIVED & FILED
DIANE FRANKOVICH
MACKINAC COUNTY REGISTER OF DEEDS

DEC 29 1997

AM 7|8|9|10|11|12|1|2|3|4|5|6 PM

Register of Deeds Stamp & File Number

4. Lot No. _____ , Recorded Plat _____
5. Private Claims _____

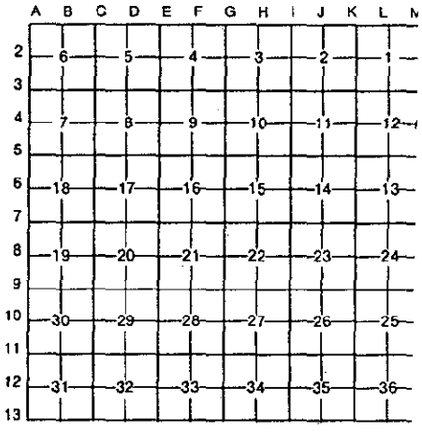

I, Neil E. Hill, in a field survey on DECEMBER 22 97, 19 _____, do hereby certify that under requirements of P.A. 74, Michigan P.A. of 1970, the corner points mentioned in lines 1 and 2 above were in conformance with regulations and rules therefore as required in the current manual of survey instructions of the United States Department of the Interior, Bureau of Land Management or by a decree of a Court of Law and/or that the corner points mentioned in lines 3, 4 and 5 above were in conformance with the rules of the Michigan Board of Land Surveyors or by a Decree of a Court of Law; established, re-established, monumented, re-monumented, recovered, found as expressed below:

NOTE: Not more than 4 corners, all in the same town and range, may be recorded on this certificate.

A. Description of original monument and accessories and/or subsequent restoration:

1840 GLO notes Wiliam Burt 6" Cedar S61W 12 lks
4" Fir N51W 5 lks

GLO 374.88' North of Section Cor

1975 Jerry Wilcox set ½" iron by MDSH ties, recorded Liber A, page 185

1996 Shown on R.S. Scott surveys of old railroad property. Distance from ¼ Corner to Section Corner to North by Sc 2629.47', measured 1997 by Hill to be 2708.56', 6.22' off line between Section Corners East.

B. Description of corner evidence found and/or method applied in restoring or reestablishing corner:

1997 Found "T"-iron rod (Old witnesses) at 375.12 ' North of Section Corner.
4" Poplar S75E 9.88 feet
4" Cottonwood S10W 19.60 feet
4" Poplar N30W 5.96 feet
31.2 feet East of I-75 East ROW fence
Accepted corner location.

ACCEPTED BY THE MACKINAC COUNTY SURVEY PEER GROUP AS THE OFFICIAL CORNER UNDER P.A. 345 OF 1990 AT A MEETING HELD ON 12-12-97

C. Description of monument for corner and accessories established to perpetuate locating the position of the corner:

Set ½" re-rod and remonumentation cap in place of "T"-iron.
14" Poplar N20W 26.42'
12" Poplar South 14.33'
12" Poplar stump N55E 04.77'
6" Poplar N80E 09.80 #16041

STATE OF MICHIGAN
NEIL E. HILL
Land Surveyor
No. 27447
REGISTERED LAND SURVEYOR

Signed by Neil E. Hill P.S. Date DECEMBER 22, 1997

Surveyor's Michigan License No. 27447

FORM APPROVED BY MICHIGAN STATE BOARD OF LAND SURVEYORS, JAN. 28, 19
REVISED MAY 14, 19
REVISED JAN., 19

E-162