

SURVEY & REMONUMENTATION

APR 03 1998 1997 Mackinac County Remonumentation Corner

LAND CORNER RECORDATION CERTIFICATE Filing Requirement of Act 74, Mich. P.A. 1970

For corners in **SECTION**

<u>Mackinac</u> <small>(County)</small>	Located In:	Corner Code #	
1. Public Land Survey	T 42NR 1W	M-13	
Township corner	N 1NR 1W	m-1	
	N 2NR 1E	A-13	
	N 1NR 1E	A-1 ✓	
2. Property Controlling in Section	S ___ T ___ R ___		
3. Miscellaneous Property in Sec.	S ___ T ___ R ___		
	S ___ T ___ R ___		
	S ___ T ___ R ___		

RECEIVED & FILED
DIANE FRANKOVICH
MACKINAC COUNTY REGISTER OF DEEDS

DEC 31 1997

AM _____ PM _____
7:8:9:10:11:12:13:14:15:16

Register of Deeds Stamp & File Number

4. Lot No. _____, Recorded Plat _____
5. Private Claims _____

I, David B. Guthrie, in a field survey on Dec. 16, 19 97 do hereby state that under requirements of P.A. 74, Michigan P.A. of 1970, the corner points mentioned in lines 1 and 2 above were in conformance with regulations and rules therefore as required in the current manual of survey instructions of the United States Department of the Interior, Bureau of Land Management or by a decree of a Court of Law and /or that the corner points mentioned in lines 3, 4 and 5 above were in conformance with the rules of the Michigan Board of Land Surveyors or by a Decree of a Court of Law; established, re-established, monumented, recovered, found as expressed below:

NOTE: Not more than 2 corners, all in the same town and range, may be recorded on this certificate.


1	A	B	C	D	E	F	G	H	I	J	K	L	M
2	6		5		4		3		2		1		
3													
4	7		8		9		10		11		12		
5													
6	18		17		16		15		14		13		
7													
8	19		20		21		22		23		24		
9													
10	30		29		28		27		26		25		
11													
12	31		32		33		34		35		36		
13													

A. Description of original monument and accessories and/or subsequent restoration:
1840: G.L.O. Survey by Wm. A. Burt - Set Post and Referenced
1973: Survey by Mary C. Fientdt - Found iron at intersection.
Liber A Pages 095-096

B. Description of corner evidence found and/or method applied in restoring or reestablishing corner:
1997: Remonumentation survey by R.S. Scott Associates, Inc.
Found 1/2" Iron Rod.
This corner position is compatible with County and local surveys. This corner position is accepted as a careful and faithful perpetuation of the position of the original corner.

ACCEPTED BY THE MACKINAC COUNTY
SURVEY PEER GROUP AS THE
OFFICIAL CORNER UNDER PA.
345 OF 1990 AT A MEETING
HELD ON 12-19-97

C. Description of monument for corner and accessories established to perpetuate locating the position of the corner:
1997: Placed a 3" Mackinac County Cap stamped to identify the corner over 1/2" Iron Rod in Monument Box.
Referenced -
N42°E - 34.95' - P.P.
S67°W - 31.23' - P.P.
S67°E - 56.17' - P.P.
N81°E - 142.51' - P.P.

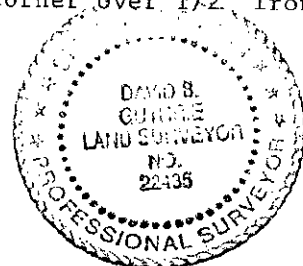

Signed by *D.B. Guthrie*
Surveyor's Michigan License No. 22435

Date 12-22-97