

SURVEY & REMONUMENTATION

MAR 13 1998

**SECTION 1997 Mackinac County Remonumentation Corner
LAND CORNER RECORDATION CERTIFICATE
Filing Requirement of Act 74, Mich. P.A. 1970**

For corners in

<u>Mackinac</u> (County)	Located In:	Corner Code #
1. Public Land Survey	T <u>42NR 1W</u>	<u>L-13</u>
	T <u>41NR 1W</u>	<u>L-1</u> ✓
	T ___ R ___	_____
	T ___ R ___	_____
2. Property Controlling in Section	S ___ T ___ R ___	_____
	S ___ T ___ R ___	_____
3. Miscellaneous Property in Sec.	S ___ T ___ R ___	_____
	S ___ T ___ R ___	_____

RECEIVED & FILED
DIANE FRANKONICH
MACKINAC COUNTY REGISTER OF DEEDS
DEC 31 1997
AA
7:18 PM
2/18/98

Register of Deeds Stamp & File Number

4. Lot No. _____, Recorded Plat _____
5. Private Claims _____

I, David B. Guthrie, in a field survey on Dec. 16, 19 97 do hereby state that under requirements of P.A. 74, Michigan P.A. of 1970, the corner points mentioned in lines 1 and 2 above were in conformance with regulations and rules therefore as required in the current manual of survey instructions of the United States Department of the Interior, Bureau of Land Management or by a decree of a Court of Law and/or that the corner points mentioned in lines 3, 4 and 5 above were in conformance with the rules of the Michigan Board of Land Surveyors or by a Decree of a Court of Law; established, re-established, monumented, recovered, found as expressed below:

NOTE: Not more than 2 corners, all in the same town and range, may be recorded on this certificate.


A	B	C	D	E	F	G	H	I	J	K	L	M
1												
2	6		5		4		3		2		1	
3												
4	7		8		9		10		11		12	
5												
6	18		17		16		15		14		13	
7												
8	19		20		21		22		23		24	
9												
10	30		29		28		27		26		25	
11												
12	31		32		33		34		35		36	
13												

- A. Description of original monument and accessories and/or subsequent restoration:
 1840: Survey by Wm. A. Burt - Set Post and Referenced
 1973: Survey by Mary C. Fiendt - Found 1/4" solid Rod Liber A Pages 095-096
 1978: Survey by Lawrence R. Fiendt - Found 1/4" rod, reset with "T" iron.
 1984: Survey by William L. Karr - Found "T" iron
 1990: Survey by William L. Karr - Found "T" iron
- B. Description of corner evidence found and/or method applied in restoring or reestablishing corner:
 1997: Remonumentation survey by R.S. Scott Associates, Inc.

This corner position is compatible with County and local surveys. This corner position is accepted as a careful and faithful perpetuation of the position of the original corner.

ACCEPTED BY THE MACKINAC COUNTY SURVEY PEER GROUP AS THE OFFICIAL CORNER UNDER P.A. 345 OF 1990 AT A MEETING HELD ON 12-19-97

- C. Description of monument for corner and accessories established to perpetuate locating the position of the corner:
 1997: Placed a 3" Mackinac County Cap stamped to identify the corner over 1/2" Iron Rod, over "T" iron, in Monument Box.
 Referenced -
 N80°E - 78.48' - P.P.
 (Exist.) Tag#22428 - S05°E - 87.34' - P.P.
 (Exist.) Tag#22428 - N80°W - 98.87' - P.P.
 S58°W - 83.58' - 14" Poplar

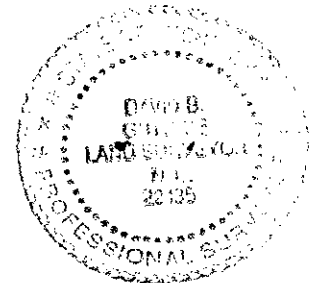

Signed by D.B. Guthrie
 Surveyor's Michigan License No. 22435

Date 12-22-97