


JAN 21 1999

# T41N R03W SECTION

St. Ignace Twp.

A B C D E F G H I J K L M

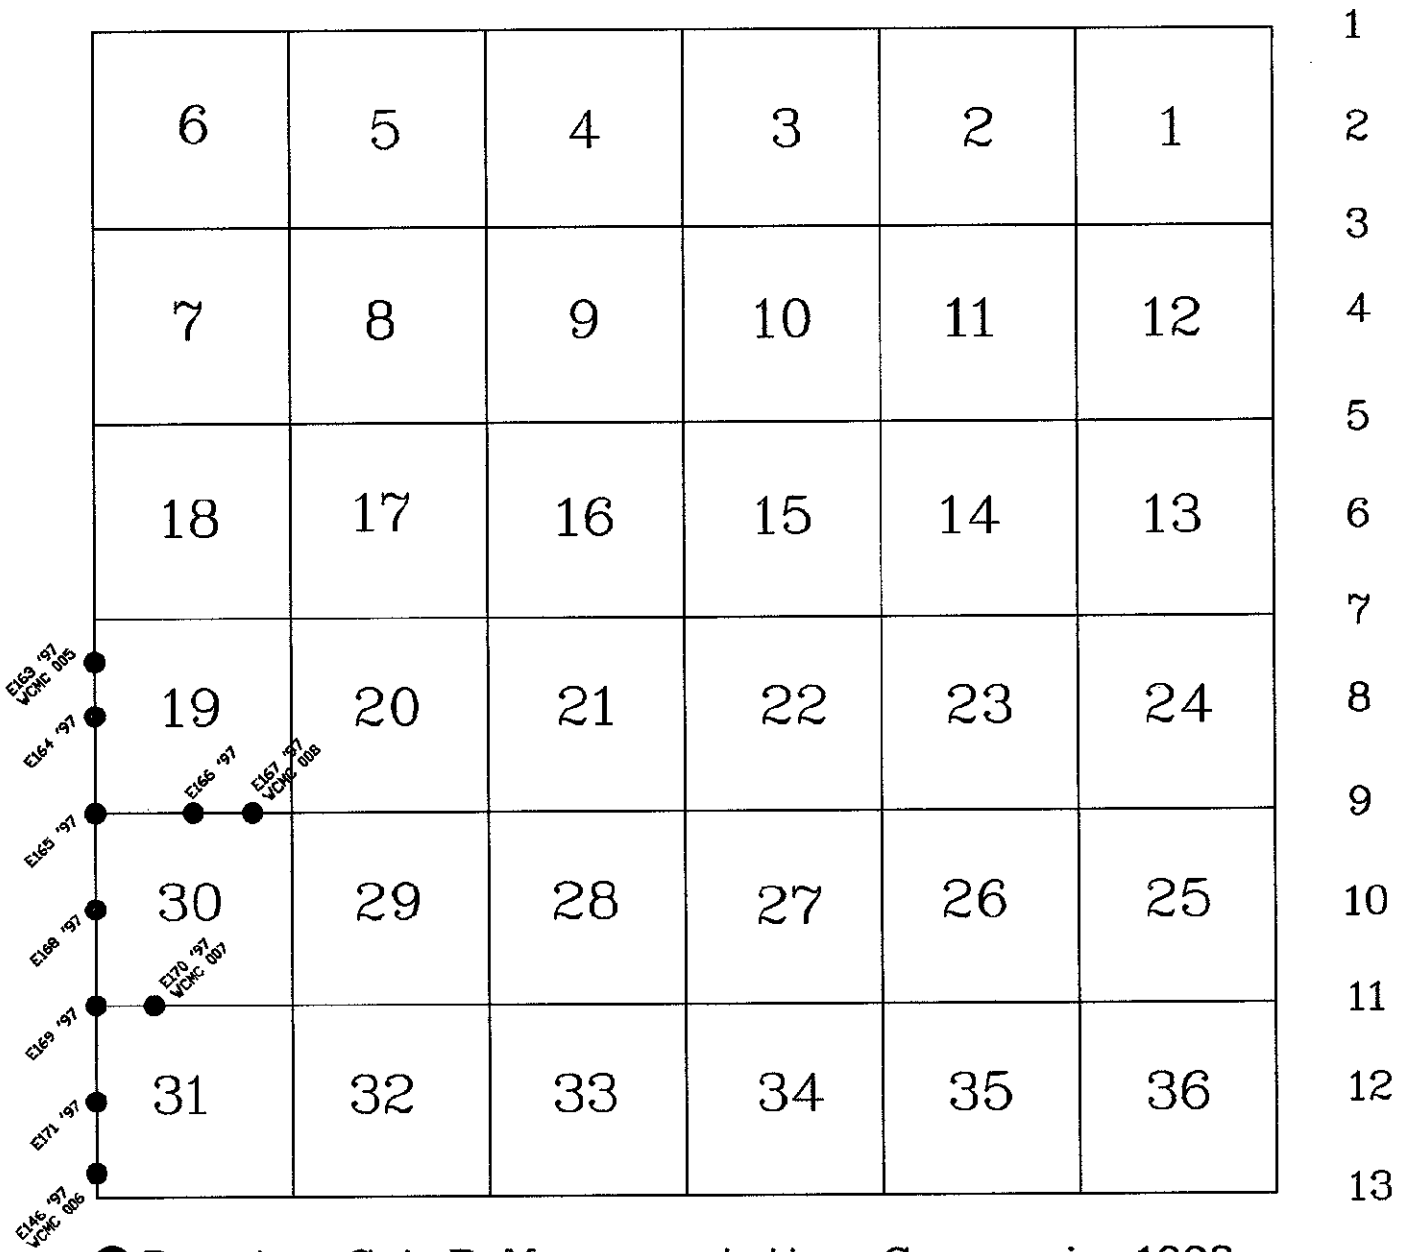

● Denotes Set ReMonumentation Corner in 1998

● Denotes Previously Set ReMonumentation Corner