SURVEY &
REMONUMENTATION

MAR 13 1998

SECTION

# MACKINAC COUNTY REMONUMENTATION CORNER

## LAND CORNER RECORDATION CERTIFICATE

**Filing Requirement of Act 74, Mich. P.A. 1970**

RECEIVED & FILED
DIANE FRAFKOVICH
MACKINAC COUNTY REGISTER OF DEEDS

DEC 29 1997
AM PM

**Register of Deeds Stamp & File Number**

For corners in

Mackinac
(County)

| | Located In: | Corner Code # |
|---|---|---|
| 1. Public Land Survey | T 41N R 3W | A-10 ✓ |
| | T ___ R ___ | ~~W¼ cor. Sec 30~~ |
| | T 41N R 4W | M-10 |
| | T ___ R ___ | ~~E¼ Cor, Sec 25~~ |
| 2. Property Controlling | S ___ T ___ R ___ | |
| in Section | S ___ T ___ R ___ | |
| 3. Miscellaneous | S ___ T ___ R ___ | |
| *Property in Sec.* | S ___ T ___ R ___ | |

4. Lot No. _____ , Recorded Plat _____
5. Private Claims _____

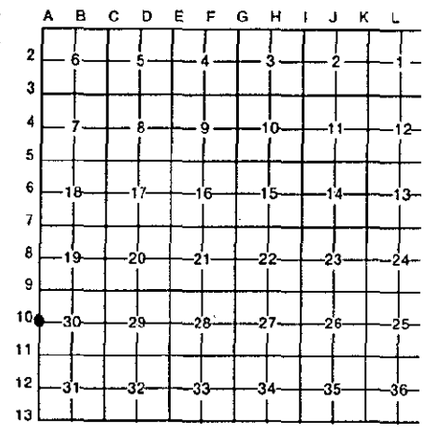


I, Neil E. Hill, in a field survey on DECEMBER 22 97, 19 _____, do hereby certify that under requirements of P.A. 74, Michigan P.A. of 1970, the corner points mentioned in lines 1 and 2 above were in conformance with regulations and rules therefore as required in the current manual of survey instructions of the United States Department of the Interior, Bureau of Land Management or by a decree of a Court of Law and/or that the corner points mentioned in lines 3, 4 and 5 above were in conformance with the rules of the Michigan Board of Land Surveyors or by a Decree of a Court of Law; established, re-established, monumented, re-monumented, recovered, found as expressed below:

**NOTE: Not more than 4 corners, all in the same town and range, may be recorded on this certificate.**

A. Description of original monument and accessories and/or subsequent restoration:

1840 GLO notes William Burt 4" Cedar N13E 17 lks
4" Cedar S13W 17 lks

1980 L. Feindt set 1" pipe in position of old cedar stake
Recorded Liber B, page 176

B. Description of corner evidence found and/or method applied in restoring or reestablishing corner:

1997 Found 1" pipe. (Old witnesses)

| | | |
|---|---|---|
| 1" Bar set by T.L. J. | S01W | 4.65 feet |
| 1" Bar set b T.L. J. | S81E | 26.48 feet |
| 6" Cedar | N50E | 14.07 feet |
| 10" Cedar Stump | S15W | 11.80 feet |
| 12" Cedar Stump | N15E | 10.60 feet |

Accepted corner location.

ACCEPTED BY THE MACKINAC COUNTY SURVEY PEER GROUP AS THE OFFICIAL CORNER UNDER P.A. 345 OF 1990 AT A MEETING HELD ON 12-12-97

C. Description of monument for corner and accessories established to perpetuate locating the position of the corner:

Set ⅝" rerod with remonumentation cap inside found pipe.
8" Cedar S60W 09.05'
10" Spruce N35W 15.66'
10" Cedar N50E 14.02'
6" Spruce S60E 04.87'

STATE OF MICHIGAN
NEIL E. HILL
Land Surveyor
No. 27447
REGISTERED LAND SURVEYOR

Signed by Neil E. Hill P.S. Date DECEMBER 22, 1997

Surveyor's Michigan License No. 27447

FORM APPROVED BY MICHIGAN STATE BOARD OF LAND SURVEYORS, JAN. 28, 197
REVISED MAY 14, 197
REVISED JAN., 198

F-168