



LAND CORNER RECORDATION CERTIFICATE
Filing Requirement of Act 74, Mich. P.A. 1970

For corners in Mackinac Located In: _____ Corner Code # _____
 (County)

1. Public Land Survey	T	<u>41N</u>	R	<u>4W</u>	<u>D-3</u>	
	T	_____	R	_____	_____	
	T	_____	R	_____	_____	
	T	_____	R	_____	_____	
2. Property Controlling in Section	S	_____	T	_____	R	_____
	S	_____	T	_____	R	_____
3. Miscellaneous Property in Section	S	_____	T	_____	R	_____
	S	_____	T	_____	R	_____

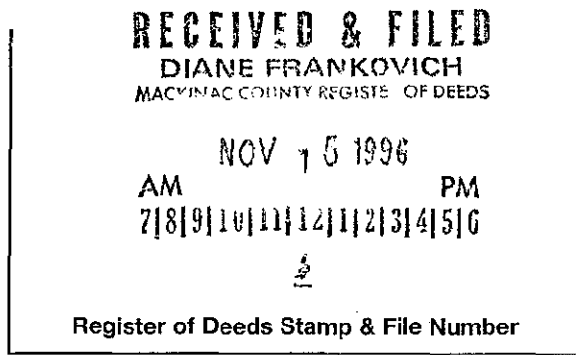

4. Lot No. _____, Recorded Plat _____
 5. Private Claims _____

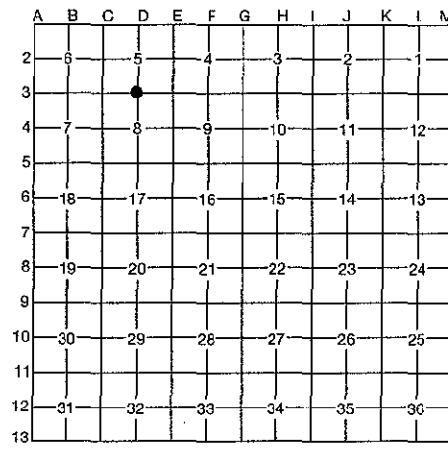

I, David B. Guthrie in a field survey on July 11, 1996, do hereby certify that under requirements of P.A. 74, Michigan P.A. of 1970, the corner points mentioned in lines 1 and 2 above were in conformance with regulations and rules therefore as required in the current manual of survey instructions of the United States Department of the Interior, Bureau of Land Management or by a decree of a Court of Law and/or that the corner points mentioned in lines 3, 4 and 5 above were in conformance with the rules of the Michigan Board of Professional Surveyors or by a Decree of a Court of Law; established, re-established, monumented, re-monumented, recovered, found as expressed below:

NOTE: Not more than 4 corners, all in the same town and range, may be recorded on this certificate.

A. Description of original monument and accessories and/or subsequent restoration:

1845: G.L.O. Survey by J.A. Mullett - Set Post and Referenced Cedar 20- N35E - 11 / Tamarack 10 - S35W - 09

B. Description of corner evidence found and/or method applied in restoring or reestablishing corner:

1996: Found remnants of an old wood stake at the intersection of fences North and West.

SURVEY & REMONUMENTATION

MAY 20 1997

COMMISSION

ACCEPTED BY THE MACKINAC COUNTY SURVEY PEER GROUP AS THE OFFICIAL CORNER UNDER P.A. 345 OF 1990 AT A MEETING HELDON 8-20-96

James H. Granger

C. Description of monument for corner and accessories established to perpetuate locating the position of the corner:

1996: Set 5/8" x 24" Iron Rod with an Aluminum Cap stamped to identify the corner.

- Referenced: S35°W - 7" Cedar - 9.05 Feet
- S55°E - 8" Cedar - 12.90 Feet
- N40°W - 10" Spruce - 9.20 Feet
- N40°E - 18" Cedar - 25.80 Feet



Signed by _____

David B. Guthrie

Date Sept. 30, 1996

Surveyor's Michigan License No. 22435