

LAND CORNER RECORDATION CERTIFICATE
Filing Requirement of Act 74, Mich. P.A. 1970

For corners in Mackinac Located In: _____ Corner Code # _____
 (County)

1. Public Land Survey	T <u>41N</u> R <u>4W</u>	<u>E-2</u>
	T _____ R _____	_____
	T _____ R _____	_____
	T _____ R _____	_____
2. Property Controlling in Section	S _____ T _____ R _____	_____
	S _____ T _____ R _____	_____
3. Miscellaneous Property in Section	S _____ T _____ R _____	_____
	S _____ T _____ R _____	_____

RECEIVED & FILED
DIANE FRANKOVICH
 MACKINAC COUNTY REGISTRE. OF DEEDS

NOV 7 5 1996
 AM _____ PM _____
 7|8|9|10|11|12|1|2|3|4|5|6

Register of Deeds Stamp & File Number

4. Lot No. _____, Recorded Plat _____
 5. Private Claims _____

A	B	C	D	E	F	G	H	I	J	K	L	M
2	6	5	4	3	2							
3												
4	7	8	9	10	11	12						
5												
6	18	17	16	15	14	13						
7												
8	19	20	21	22	23	24						
9												
10	30	29	28	27	26	25						
11												
12	31	32	33	34	35	36						
13												

I, David B. Guthrie in a field survey on April 17, 1996, do hereby certify that under requirements of P.A. 74, Michigan P.A. of 1970, the corner points mentioned in lines 1 and 2 above were in conformance with regulations and rules therefore as required in the current manual of survey instructions of the United States Department of the Interior, Bureau of Land Management or by a decree of a Court of Law and/or that the corner points mentioned in lines 3, 4 and 5 above were in conformance with the rules of the Michigan Board of Professional Surveyors or by a Decree of a Court of Law; established, re-established, monumented, re-monumented, recovered, found as expressed below:

NOTE: Not more than 4 corners, all in the same town and range, may be recorded on this certificate.

A. Description of original monument and accessories and/or subsequent restoration:

- 1845: G.L.O. Survey by J.A. Mullett - Set Post and Referenced Sugar 12 - S65W - 10 / Beech 6 - N42E - 18
- 1986: Survey by MDOT - Set P.K. Nail in M-123 0.6 Ft. East of C.L. in line w/Fe. E-W & Sec. Cor. N/S.
- 1995: Survey by MDOT - Found P.K. Nail 0.6 Ft. East of C.L. M-123. Set 1/2" Iron Rod.

B. Description of corner evidence found and/or method applied in restoring or reestablishing corner:

- 1996: Found 1/2" Iron Rod 0.6 Feet East of C.L. M-123.

SURVEY & REMONUMENTATION

MAY 20 1997


COMMISSION

ACCEPTED BY THE MACKINAC COUNTY SURVEY PEER GROUP AS THE OFFICIAL CORNER UNDER P.A. 345 OF 1990 AT A MEETING HELDON B-20-96

James H. Granger

C. Description of monument for corner and accessories established to perpetuate locating the position of the corner:

- 1996: Placed an Aluminum Cap stamped to identify the corner on a 5/8" Iron Rod in a Monument Box.
 Referenced: S80°E - Wood Post - 106.84 Feet
 N54°E - 4" Apple in clump - 68.41 Feet
 N70°W - Drill hole in Culv. ring - 40.46 Feet
 S80°W - Drill hole in Culv. ring - 40.16 Feet

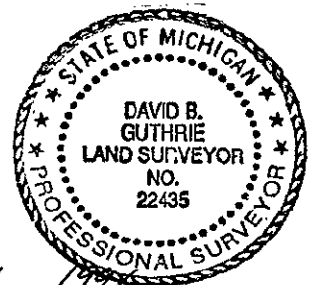

Signed by David B. Guthrie

Date Oct. 1, 1996

Surveyor's Michigan License No. 22435