

**LAND CORNER RECORDATION CERTIFICATE**  
**Filing Requirement of Act 74, Mich. P.A. 1970**

For corners in Mackinac Located In: \_\_\_\_\_ Corner Code # \_\_\_\_\_  
 (County)

1. Public Land Survey	T <u>41N</u> R <u>4W</u>	<u>F-3</u>
	T _____ R _____	_____
	T _____ R _____	_____
	T _____ R _____	_____
2. Property Controlling in Section	S _____ T _____ R _____	_____
	S _____ T _____ R _____	_____
3. Miscellaneous Property in Section	S _____ T _____ R _____	_____
	S _____ T _____ R _____	_____

**RECEIVED & FILED**  
**DIANE FRANKOVICH**  
 MACKINAC COUNTY REGISTER OF DEEDS

NOV 15 1996  
 AM \_\_\_\_\_ PM \_\_\_\_\_  
 7|8|9|10|11|12|1|2|3|4|5|6

Register of Deeds Stamp & File Number

4. Lot No. \_\_\_\_\_, Recorded Plat \_\_\_\_\_  
 5. Private Claims \_\_\_\_\_

A	B	C	D	E	F	G	H	I	J	K	L	M
2	6	5	4	3	2	1						
3												
4	7	8	9	10	11	12						
5												
6	18	17	16	15	14	13						
7												
8	19	20	21	22	23	24						
9												
10	30	29	28	27	26	25						
11												
12	31	32	33	34	35	36						
13												

I, David B. Guthrie in a field survey on April 17, 1996, do hereby certify that under requirements of P.A. 74, Michigan P.A. of 1970, the corner points mentioned in lines 1 and 2 above were in conformance with regulations and rules therefore as required in the current manual of survey instructions of the United States Department of the Interior, Bureau of Land Management or by a decree of a Court of Law and/or that the corner points mentioned in lines 3, 4 and 5 above were in conformance with the rules of the Michigan Board of Professional Surveyors or by a Decree of a Court of Law; established, re-established, monumented, re-monumented, recovered, found as expressed below:

**NOTE: Not more than 4 corners, all in the same town and range, may be recorded on this certificate.**

**A. Description of original monument and accessories and/or subsequent restoration:**

- 1845: G.L.O. Survey by J.A. Mullett - Set Post and Referenced Sugar 10 - N45E - 19
- 1957: Survey by MDOT - 1" Bolt
- 1986: Survey by MDOT - Found 1" Pin in Mon. Box 1.5 Ft. North of C.L. M-123.
- 1995: Survey by MDOT - Found 1" Pin in Mon. Box 1.5 Ft. North of C.L. M-123. Verified 1986 references.

**B. Description of corner evidence found and/or method applied in restoring or reestablishing corner:**

1996: Found 1" Iron Pin in Mon. Box 1.5 Feet North of the centerline of Hwy. M-123.

**SURVEY & REMONUMENTATION**

MAY 20 1997

COMMISSION


ACCEPTED BY THE MACKINAC COUNTY SURVEY PEER GROUP AS THE OFFICIAL CORNER UNDER P.A. 345 OF 1990 AT A MEETING HELD ON 8-20-96

*James H. Kranger*

**C. Description of monument for corner and accessories established to perpetuate locating the position of the corner:**

1996: Placed a 5/8" x 24" Iron Rod with an Aluminum Cap stamped to identify the corner in a Monument Box.

- Referenced: N35°E - Utility Pole - 62.68 Feet
- S25°E - N.E. Cor. Hse. - 100.70 Feet
- S05°E - N.W. Cor. Hse. - 86.96 Feet
- S35°W - Anchor Pole - 81.78 Feet
- N35°W - Drill hole in Conc. Hdwl. - 41.31 Feet

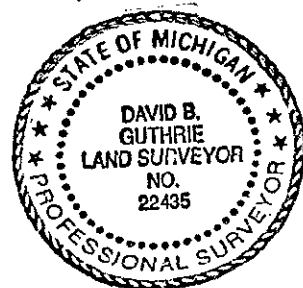

Signed by David B. Guthrie

Date Oct. 1, 1996

Surveyor's Michigan License No. 22435