

MAR 20 2000

LAND CORNER RECORDATION CERTIFICATE
Filing Requirement of Act 74, Mich. P.A. 1970

SECTION

Mackinac County Remonumentation Corner

For corners in

Table with columns: Mackinac County, Located in:, Corner Code #. Rows include Public Land Survey, Property Controlling in Section, Miscellaneous Property in Sec., Lot No., and Private Claims.

RECEIVED & FILED
DIANE FRANKOVICH
MACKINAC COUNTY REGISTER OF DEEDS

FEB 25 2000

AM PM
7|8|9|10|11|12|1|2|3|4|5|6

Register of Deeds Stamp & File Number

Grid with columns A-M and rows 1-13. A dot is marked at row 3, column H. Handwritten text 'T41N R04W' is written across the grid.

I, Neil E. Hill, in a field survey on 12-20-99, do hereby state that under requirements of P.A. 74, Michigan P.A. of 1970, the corner points mentioned in lines 1 and 2 above were in conformance with regulations and rules therefore as required in the current manual of survey instructions of the United States Department of the Interior, Bureau of Land Management or by a decree of a Court of Law and /or that the corner points mentioned in lines 3, 4 and 5 above were in conformance with the rules of the Michigan Board of Land Surveyors or by a Decree of a Court of Law; established, re-established, monumented, recovered, found as expressed below:

NOTE: Not more than 2 corners, all in the same town and range, may be recorded on this certificate.

A. Description of original monument and accessories and/or subsequent restoration:

1845 GLO Notes A Burt 8" Tamarack N 28 W 07 lks
4" Spruce S 04 E 09 lks

No Subsequent Information

ACCEPTED BY THE MACKINAC COUNTY SURVEY PEER GROUP AS THE OFFICIAL CORNER UNDER P.A. 345 OF 1990 AT A MEETING HELD ON 12-03-99

Neil E. Hill


B. Description of corner evidence found and/or method applied in restoring or reestablishing corner:

1999 Set 1/2" rod with 4" Alum remonumentation cap with monument box (Spring 2000) Midway and on line between section corners to the East and West

C. Description of monument for corner and accessories established to perpetuate locating the position of the corner:

Corner is a 1/2" rod with 4" Alum remonumentation cap in monument box

6" Spruce S 35 E 77.92'
6" Cedar S 10 W 57.98'
6" Balsam N 25 W 41.48'
4" Spruce N 35 E 47.82'

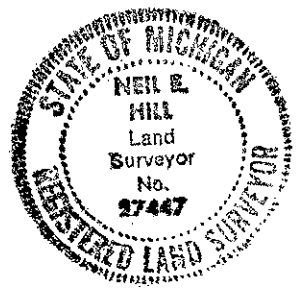

Bearings are compass bearings, corrected for declination, all distances are to a double-head nail in the side of the witness object unless otherwise noted.

Signed by Neil E. Hill P.S.P.C.

Date January 21 2000

Surveyor's Michigan License No. 27447

F 00011