

**LAND CORNER RECORDATION CERTIFICATE**  
Filing Requirement of Act 74, Mich. P.A. 1970

MAR 20 2000

**Mackinac County Remonumentation Corner**

**SECTION**

For corners in

Mackinac County	Located in:	Corner Code #
1. Public Land Survey	T41N R04W	J-3
	T R	
	T R	
	T R	
2. Property Controlling in Section	S T R	
	S T R	
3. Miscellaneous Property in Sec.	S T R	
	S T R	
4. Lot No.	Recorded Plat	
5. Private Claims		

**RECEIVED & FILED**  
DIANE FRANKOVICH  
MACKINAC COUNTY REGISTER OF DEEDS

FEB 25 2000

AM PM  
9/9/10/11/12/13/14/15

Register of Deeds Stamp & File Number

A	B	C	D	E	F	G	H	I	J	K	L	M
1												
2	6	5	4	3	2	1						
3												
4	7	8	9	10	11	12						
5												
6	18	17	16	15	14	13						
7												
8	19	20	21	22	23	24						
9												
10	30	29	28	27	26	25						
11												
12	31	32	33	34	35	36						
13												

I, Neil E. Hill, in a field survey on 12-20-99, do hereby state that under requirements of P.A. 74, Michigan P.A. of 1970, the corner points mentioned in lines 1 and 2 above were in conformance with regulations and rules therefore as required in the current manual of survey instructions of the United States Department of the Interior, Bureau of Land Management or by a decree of a Court of Law and /or that the corner points mentioned in lines 3, 4 and 5 above were in conformance with the rules of the Michigan Board of Land Surveyors or by a Decree of a Court of Law; established, re-established, monumented, recovered, found as expressed below:

NOTE: Not more than 2 corners, all in the same town and range, may be recorded on this certificate.

A. Description of original monument and accessories and/or subsequent restoration:

1845 GLO Notes J H Mullett      10" Beech      S 15 W      32 lks  
 18" Beech      S 77 E      30 lks

No Subsequent Information

ACCEPTED BY THE MACKINAC COUNTY  
SURVEY PEER GROUP AS THE  
OFFICIAL CORNER UNDER P.A.  
345 OF 1990 AT A MEETING  
HELD ON 12-03-99

*Neil E. Hill*


B. Description of corner evidence found and/or method applied in restoring or reestablishing corner:

1999 Set 1/2" rod with 4" Alum remonumentation cap midway and on line between section corners to the East and West

C. Description of monument for corner and accessories established to perpetuate locating the position of the corner:

Corner is a 1/2" rod with 4" Alum remonumentation cap  
 Corner is on the North side of and E-W 2 track road

8" Birch      S 50 W      25.38'  
 18" Poplar      S 10 E      15.21'  
 8" Maple      N 10 E      14.51'  
 8" S Maple      N 60 E      16.42'

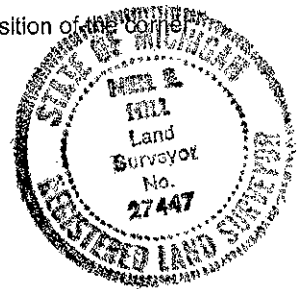

Bearings are compass bearings, corrected for declination, all distances are to a double-head nail in the side of the witness object unless otherwise noted.

January 21 2000

Signed by Neil E. Hill P.S.P.C.

Date \_\_\_\_\_

Surveyor's Michigan License No. 27447

F 00016