

MAR 20 2000

LAND CORNER RECORDATION CERTIFICATE
Filing Requirement of Act 74, Mich. P.A. 1970
Mackinac County Remonumentation Corner

SECTION

RECEIVED & FILED
 DIANE FRANKOVICH
 MACKINAC COUNTY REGISTER OF DEEDS
 FEB 25 2000
 AM PM
 7/21/9/10/11/12/1/2/3/4/5/6

Register of Deeds Stamp & File Number

For corners in

Mackinac County	Located in:	Corner Code #
1. Public Land Survey	T41N R04W	K-11
	T R	
	T R	
	T R	
2. Property Controlling in Section	S T R	
	S T R	
3. Miscellaneous Property in Sec.	S T R	
	S T R	
4. Lot No.		Recorded Plat
5. Private Claims		


I, Neil E. Hill, in a field survey on 12-20-99, do hereby state that under requirements of P.A. 74, Michigan P.A. of 1970, the corner points mentioned in lines 1 and 2 above were in conformance with regulations and rules therefore as required in the current manual of survey instructions of the United States Department of the Interior, Bureau of Land Management or by a decree of a Court of Law and /or that the corner points mentioned in lines 3, 4 and 5 above were in conformance with the rules of the Michigan Board of Land Surveyors or by a Decree of a Court of Law; established, re-established, monumented, recovered, found as expressed below:

NOTE: Not more than 2 corners, all in the same town and range, may be recorded on this certificate.

A. Description of original monument and accessories and/or subsequent restoration:

1845 GLO Notes J H Mullett	8" Tamarack	N 57 E	11 lks
	8" Beech	S 28 W	24 lks
1964 Leonard Della-Moretta	5" Cedar	S 25 W	8.8'
Fd 2 original bearing trees	7" Cedar	S 81 E	6.7'
set 2" pipe w/ brass cap			
Book 2 Page 269			
1977 Lawrence Feindt	6" Cedar	S 20 W	8.7'
Fd 2" Pipe USF cap	9" Cedar	Due E	6.5'
Liber 2 Page 343	12" Cedar	N 10 W	22.80'
1984 Harold Stockholm & Gregory Asher	6" Cedar	S 25 W	3.9'
USDA Forrest Service Map #7	9" Cedar	S 81 E	6.6'
Fd Pipe and 3 witnesses	Cedar Post	Southeast	0.5'
	4" Cedar	N 85 W	41.1'
	7" W Birch	N 10 W	24.2'
1984 Gragory Asher	7" W Birch	N 10 W	24.2'
Fd pipe and 2 witnesses	4" Cedar	N 85 W	41.1'
Liber C Page 056			

ACCEPTED BY THE MACKINAC COUNTY SURVEY PEER GROUP AS THE OFFICIAL CORNER UNDER P.A. 345 OF 1990 AT A MEETING HELD ON 12-03-99
Neil E Hill

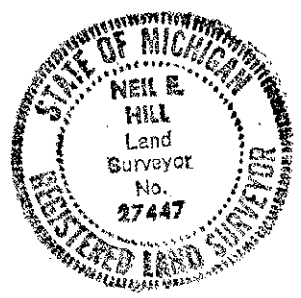

No Subsequent Information

B. Description of corner evidence found and/or method applied in restoring or reestablishing corner:

1999 Fd 2" Pipe w/ brass cap and 2 witnesses
 Accepted corner location

C. Description of monument for corner and accessories established to perpetuate locating the position of the corner:

Corner is a 2" pipe with brass cap			
7" W Birch	N 10 W	23.70'	Hand-held GPS position:
5" Cedar	N 85 W	40.93'	45-54-41 North
6" Cedar	S 25 W	8.93'	84-45-32 West
8" Cedar	N 35 E	23.44'	

Bearings are compass bearings, corrected for declination, all distances are to a double-head nail in the side of the witness object unless otherwise noted.

January 21 2000

Signed by: Neil E Hill P.S.P.C. Date _____

Surveyor's Michigan License No. 27447