

LAND CORNER RECORDATION CERTIFICATE Filing Requirement of Act 74, Mich. P.A. 1970

MAR 2 0 2000

SECTION

Mackinac County Remonumentation Corner

Corner Code # Located in: Mackinac County T41N R04W 1. Public Land Survey Т R R Ţ R Τ R Т S 2. Property Controlling R in Section S T S T R 3. Miscellaneous Property in Sec.

BEDEIVED & FILED DIANE FRANKOVICH MACKINAC COUNTY REGISTS. OF DEEDS

FEB 2 5 2000


> С 0

Register of Deeds Stamp & File Number F

G

Ε

4. Lot No.


For corners in

, Recorded Plat


5. Private Claims

I, Neil E. Hill, in a field survey on 12-20-99, do hereby state that under requirements of P.A. 74, Michigan P.A. of 1970, the corner points mentioned in lines 1 and 2 above were in conformance with regulations and rules therefore as required in the current manual of survey instructions of the United States Department of the Interior, Bureau of Land Management or by a decree of a Court of Law and /or that the corner points mentioned in lines 3, 4 and 5 above were in conformance with the rules of the Michigan Board of Land Surveyors or by a Decree of a Court of Law; established, re-established, monumented, recovered, found as expressed below:

NOTE: Not more than 2 corners, all in the same town and range, may be recorded on this certificate.

 

1845 GLO Notes J H Mullett	10" Beech	N 52 E	35 lks
	12" Beech	S 48 E	25 lks
1973 Glenn Bergey Fd wood post Replaced w/ Con Mon Liber A Page 092	6" W Birch 5" W Birch P Pole #767	S 18 E N 32 W N 24 E	0.13 Ch 0.18 Ch 1.71 Ch
1977 Lawrence Feindt (C A&E)	6" W Birch	S 18 E	0.13 Ch
Fd USF Con Mon	5" W Birch	N 32 W	0.18 Ch
Liber 2 Page 343	P Pole Stub	N 24 E	1.71 Ch
1984 Harold Stockholm &		N 24 E	112.9'
Gregory Asher		S 18 E	8.6'
Fd USF Con Mon		N 32 W	11.8'
USDA Forrest Service Map #7		N 90 E	4.2'

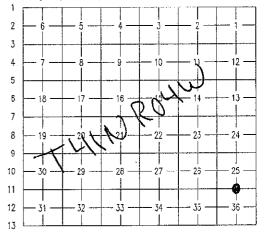

ACCEPTED BY THE MACKINAC COUNTY SURVEY PEER GROUP AS THE OFFICIAL CORNER UNDER PA. 345 OF 1990 AT A MEETING 12-03-99 HELD ON Neie E-Wille

No Subsequent Information

B. Description of corner evidence found and/or method applied in restoring or reestablishing corner:

1999 Fd USF Con Mon Accepted corner location

C. Description of monument for corner and accessories established to perpetuate locating the position of the corner:

Corner is a 4" concrete monument with brass USF cap Corner is on the West side of a power line and on North edge of gravel pit

10" Poplar	N 05 E	10.33'
4" Maple	Due E	10.71
41 Balsam	N 35 E	12.26'
Sign Post	Due E	4.2

Hand-held GPS position: 45-54-44 North

84-44-55 West

Spricyor X7... 27447

Bearings are compass bearings, corrected for declination, all distances are to a double- head nail in the side of the high establishment. uniess cinerwise noted.

E_ 4138 8530 Signed by

January Date

2000 21

NEIL E. HILL

Land

Surveyor's Michigan License No. 27447